

Name

Address

Service No. 47
\$ 7802

Location

32 Arcola St.

Kind of Pipe

Size

Size of Main

Repair—Renewal—New Service

Location

Date	Material	Amount	Total	Date	Amount
	<u>CURB TO MAIN - W.O. #5994</u>				
12/7/67	Labor	27.59			
12/13/67	Labor	<u>23.94</u>	51 53		
	10% O.H.		5 15		
11'	3/4" copper tubing @ .79		8 69		
1	Small adapter		2 76		
1	Curb Stop		8 37		
1	Box & Rod		5 10		
1	1" Nipple		65		
1	Repair clamp		5 05		
1	Lead Lined coupling		68		
2	Labor Hrs. trucking @ 3.00		6 00		
3	Hrs. Shovel @ 6.50		19 50		
			113 48		

DATE _____

TOWN OF LEXINGTON—BOARD OF PUBLIC WORKS

WATER DIVISION

The undersigned applies for a supply of water at No. _____ St. and hereby agrees to comply with the rules and regulations as now, or at any future time, established by the Board of Selectmen.


Am't. of Estimate \$ _____

Owner Hilja Kauppinen

Am't. Paid \$ _____

Address 32 Arcola St.

Builder _____

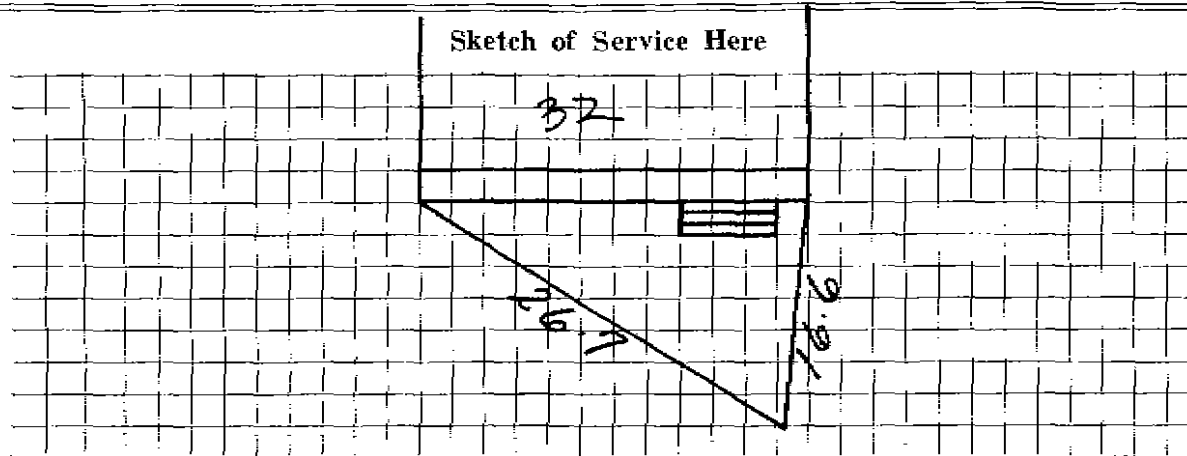

Connection made in _____ Street.

Work completed _____ 19

Remarks: