

## WATER SERVICE RECORD

Name A & E Construction Co.Service No. 344Address 33 Arcola Street, Lexington


Location

~~Repair~~ ~~Renewal~~ New ServiceComm. 11-19-56

Date	Material	Amount	Total	Date	Amount	
8/18/56	Labor	1 90		8-15-56	Deposit	50 00
	10% Overhead	20	2 10	11-19-56	Refund	25 21
	35 3/4" Copper tubing @.4850		16 98		<u>NON CHARGE</u>	24 79
	1-3/4" C x 1/2" IWH stop & waste		4 96	8/17/56	Labor	1 90
	1 hr. trucking @.75		75	37 3/4" Copper tubing @.4850		17 95
			24 79	1-3/4" C Corp Cock		4 64
				1-3/4" C Curb Cock		5 94
				1 Box & Rod		4 62
				1-1/2" straight tail piece		50
				1-1/2" offset tail piece		50
						36 05

**WATER DIVISION**

Sketch of Service Here

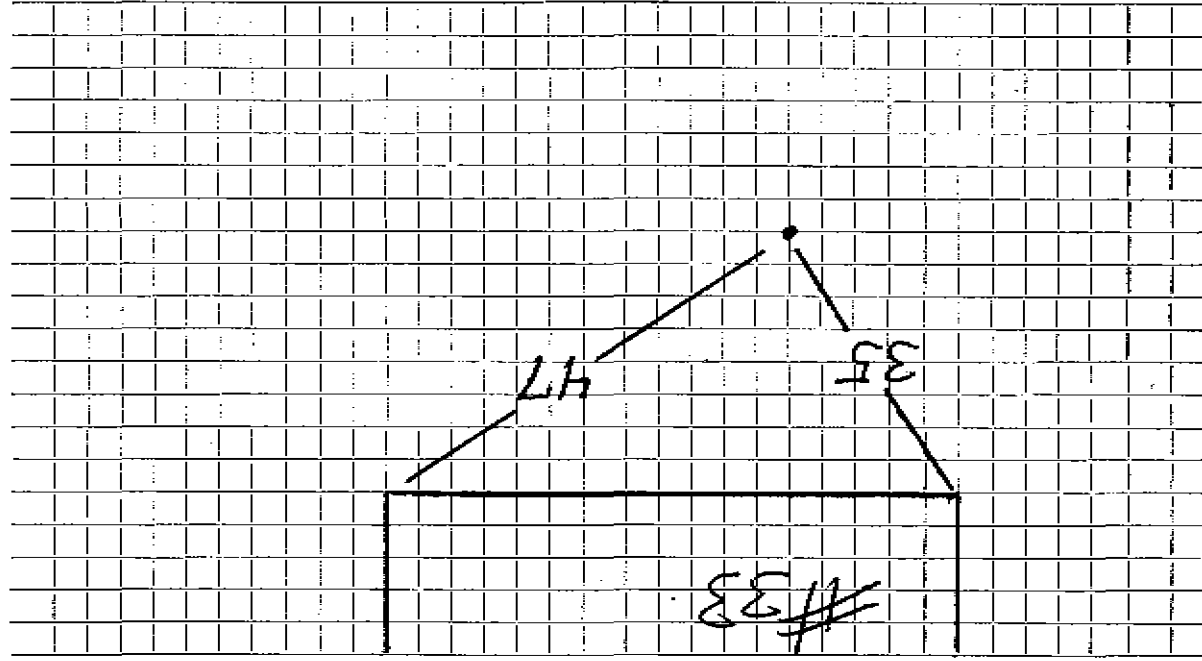

Connection made in ..... Street. Work completed .....

Remarks: .....