

Name

Address

Service No. 48

6264

Location

34 Arcola St.

Kind of Pipe

Size

Size of Main

Repair—Renewal—New Service

Location

Date

Material

Amount

Total

Date

Amount

Labor

TOWN OF LEXINGTON — BOARD OF PUBLIC WORKS

WATER DIVISION

The undersigned applies for a supply of water at No. _____ St. and hereby agrees to comply with the rules and regulations as now, or at any future time, established by the Board of Selectmen.

Am't. of Estimate \$ _____

Owner _____

Am't. Paid \$ _____


Address _____

Builder _____

Aret Hooppi

34 Arcola St.

Sketch of Service Here

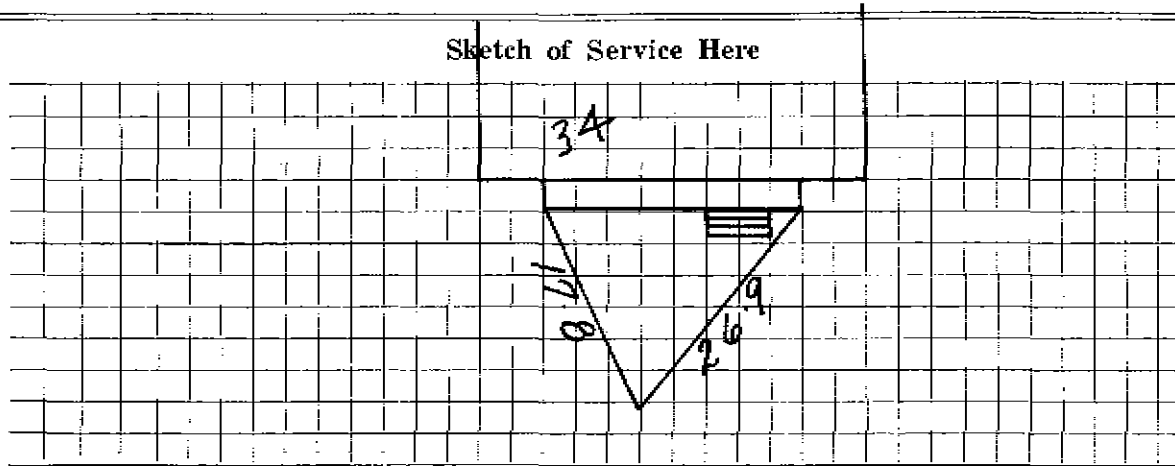

Connection made in _____ Street.

Work completed _____ 19__

Remarks: