

WATER SERVICE RECORD

Name Antonio Busa

Service No. 164

Address 40 Arcola St.

Location

Repair - Renewal - New Service

Com. F-30-54


Date	Material	Amount	Total	Date	Amount
7/8/54	Labor	7 73		<i>7-8-54 Deposited</i>	<i>50 00</i>
	10% overhead	77	8 50	<i>F-30-54 Refunded</i>	<i>(17 05)</i>
	42' - 3/4" copper tubing@.35		14 70	<u>NON CHARGE</u>	<i>32 95</i>
	1 - 3/4" C x 1/2" I.W.H. stop & waste		4 00	7/8/54 Labor	7 74
	1 hr. town shovel		5 00	12' - 3/4" copper tubing@.35	4 20
	1 hr. trucking		75	1 - 3/4" C. corp-cock	4 33
			32 95	1 - 3/4" C x 3/4" C. curb-cock	4 67
				1 box and rod	3 90
				1 - 1/2" straight tail piece	50
				1 - 3/4" offset tail piece	50
				1/2 hr. town shovel @ 5.00	2 50
				1 hr. trucking	75
					<u>29 09</u>

DATE _____

TOWN OF LEXINGTON — BOARD OF PUBLIC WORKS

WATER DIVISION

Sketch of Service Here

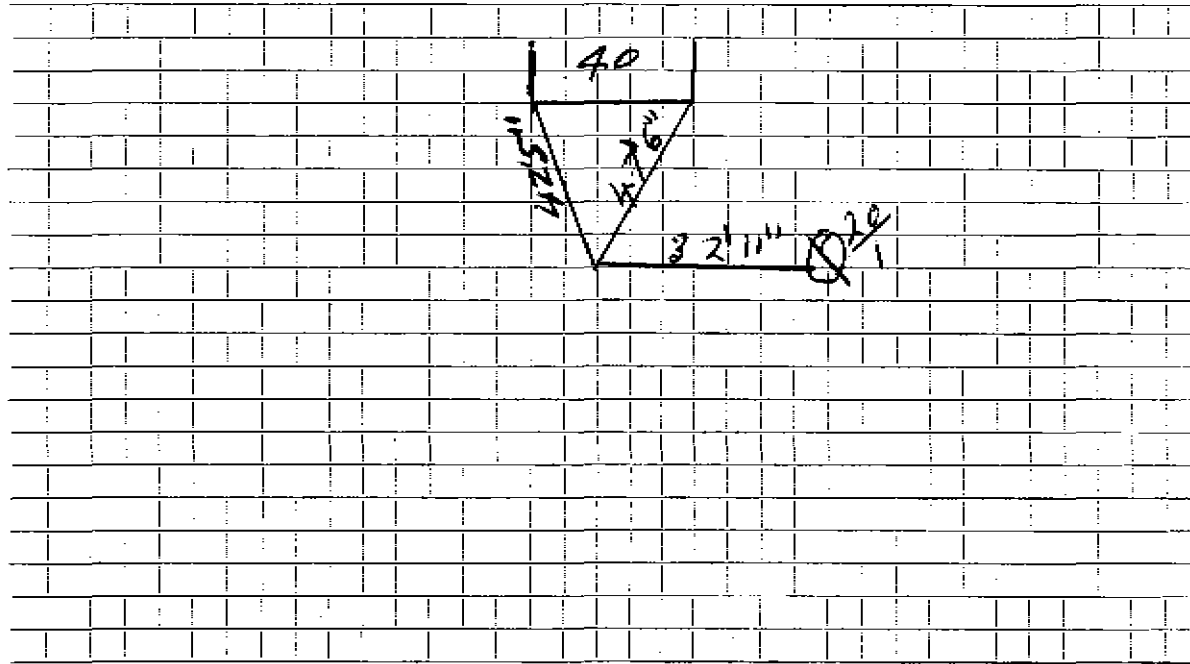

Connection made in Street. Work completed

Remarks:

.....

.....