

WATER SERVICE RECORD

Name Robert F. Hayes Inc.

Service No. 147 (1963)

Address cor. Asbury & Emerald Street

Location

~~Repair - Renewal~~ - New Service W.O. #8367

MAY 17 1965


Date	Material	Amount	Total	Date	Amount
4-9-&10-63	Labor	219.06		12-6-63	150 00
	10 ¹ / ₂ C.H.	21.91	240.97	3-21-66	181 48
	13 x 4 Patch		13.00		150 00
	25 Sticks Dynamite @.27		6.75		
	17 Blasting Caps @.28		4.76		
	4 hrs. Town Shovel @6.50		26.00		
	5 hrs. Compressor @5.00		25.00		
	5 hrs. Trucking @3.00		15.00		
			331.48		
	Supplied by Contractor				
1	6" Gate Valve				
1	6" Gate Box				
16'	6" Cast Iron Pipe				

DATE _____

TOWN OF LEXINGTON — BOARD OF PUBLIC WORKS

WATER DIVISION

Sketch of Service Here

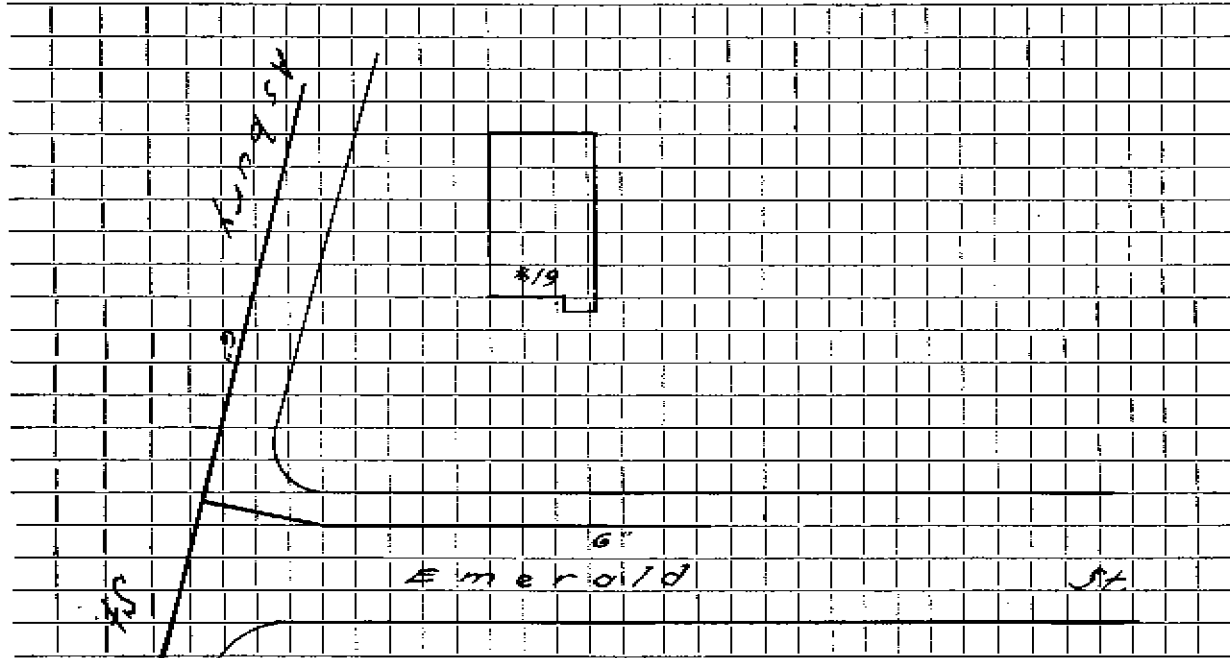

Connection made in Street. Work completed

Remarks:

.....

.....