

WATER SERVICE RECORD

2868

Name Wesley Nelson

Service No. 30

Address 10 Asbury Street

Location

~~Repair~~ New Service W.O.#7900

Comm 8-26-63


Date	Material	Amount	Total	Date		Amount
5-10-63	Labor	7.85		5-7-63	Deposit	50.00
	10% O.H.	.79	8.64	8-26-63	Paid by SHOH 38	<u>28.74</u>
	135' 3/4" Copper tubing @.42		56.70			78.74
	1 3/4" C x 1/2 I.W.H. Stop & Waste		6.17		NON CHARGE	
	3 3/4" 3 part unions @2.41		<u>7.23</u>	1 1/2	Straight tailpiece	.50
			78.74	1 1/2	Offset tailpiece	<u>.50</u>
						1.00

DATE \_\_\_\_\_

TOWN OF LEXINGTON — BOARD OF PUBLIC WORKS

**WATER DIVISION**

Sketch of Service Here

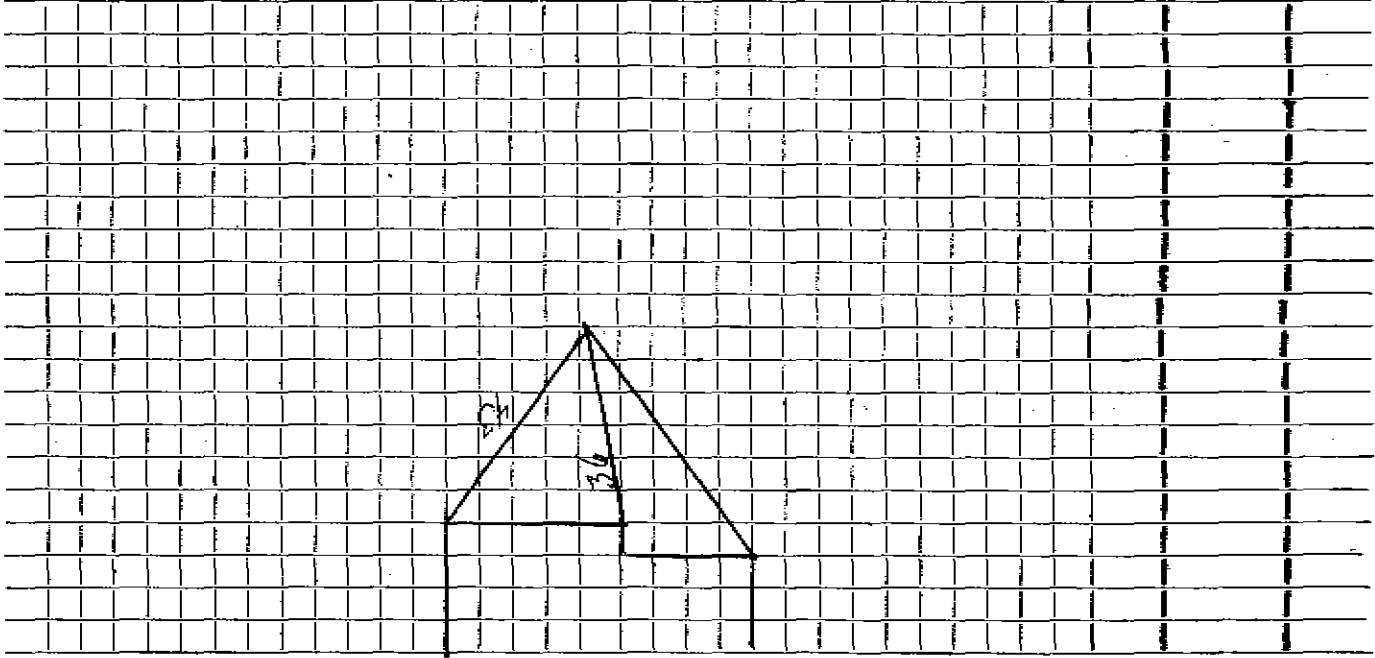

Connection made in Greenwood Street Work completed

Remarks: .....