

WATER SERVICE RECORD

6779

Name Ireland McConchie

Service No. 118

Address 25 Asbury Street

Location

Repair - ~~Renewal~~ - New Service

Jan 9-22-52


Date	Material	Amount	Total	Date	Amount
7/22/52	Labor	6 04		6-25-52 Deposited	50 00
	10% overhead	60	6 64	9-24-52 Paid	(1 18
	70' - 3/4" copper tubing@.3439		24 07		<u>NON CHARGE</u> 51 18
	1 - 3/4" C x 1/2 I.W.H. stop & waste		4 00	7/24/52 Labor	26 99
	1 - 3/4" C x 3/4" C. union 3pts.		1 72	24' - 3/4" copper tubing@.3439	8 25
	2 hrs. littlefield shovel		14 00	1 - 3/4" C. corp-cock	4 33
	1 hr. trucking		75	1 - 3/4" C x 3/4" C. curb-cock	4 67
			51 18	1 - box and rod	3 90
				1 - 1/2 offset tail piece	50
				1 - 1/2 straight tail piece	50
				6 hrs. #36 compr. @ 2.75	16 50
				3 hrs. Littlefield shovel	21 00
				1 hr. trucking	75
					<u>87 39</u>

DATE _____

TOWN OF LEXINGTON — BOARD OF PUBLIC WORKS

WATER DIVISION

Sketch of Service Here

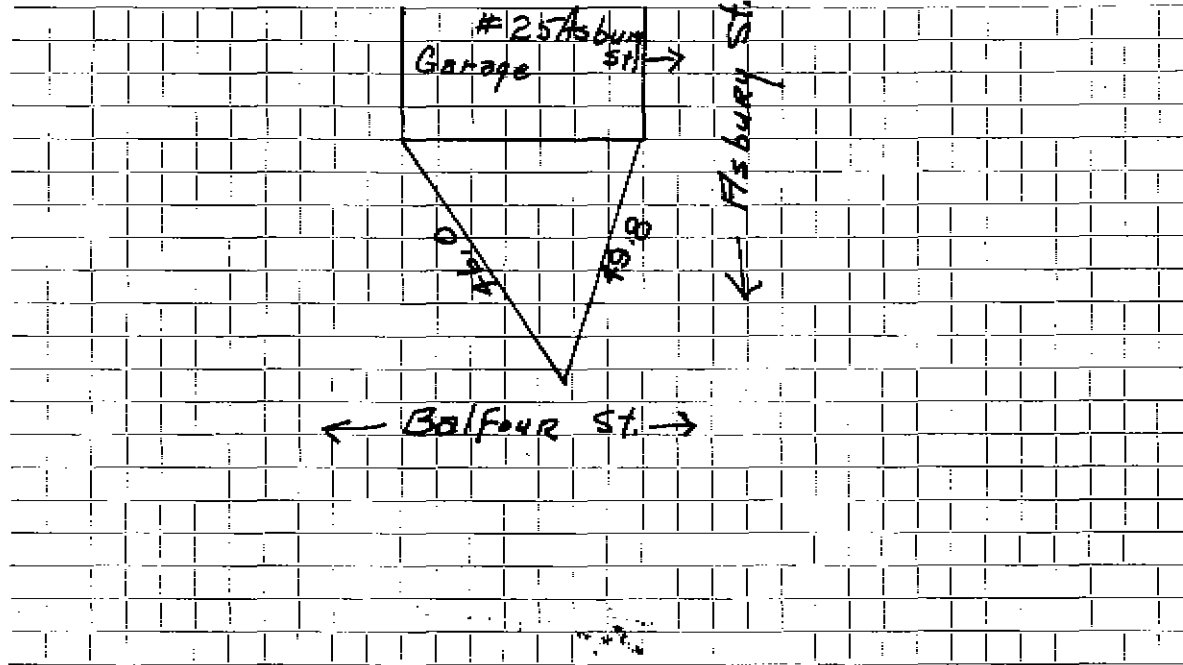

Connection made in Street. Work completed

Remarks:

.....

.....