

WATER SERVICE RECORD

Name Philip Spencer

Service No. 123

Address 41 Asbury Street

Location

~~Repair~~ ~~Renewal~~ New Service

Comm 8-22-60


Date	Material	Amount	Total	Date	Amount	
7-18-60	Labor	5 89		7-18-60	Deposit	35 00
	10% O.H.	60	6 49	7-22-60	Returned	4 22
	36' 3/4" Copper tubing #42		15 12			30 78
	1 3/4" Gx $\frac{1}{2}$ I.W.F. Stop&Waste		6 17			
	1 Hr Trucking Co. 00		3 00		NON CHARGE	
			30 78	7-18-60	Labor	18 64
					14' 3/4" Copper tubing #42-	5 88
					1 3/4" G Corp Sock	4 91
					1 3/4" G Curb Cock	6 28
					1 Box & Rod	4 90
					1 $\frac{1}{2}$ Straight tailpiece	50
					1 $\frac{1}{2}$ Offset tailpiece	50
						41 61

DATE _____

TOWN OF LEXINGTON — BOARD OF PUBLIC WORKS

WATER DIVISION

Sketch of Service Here

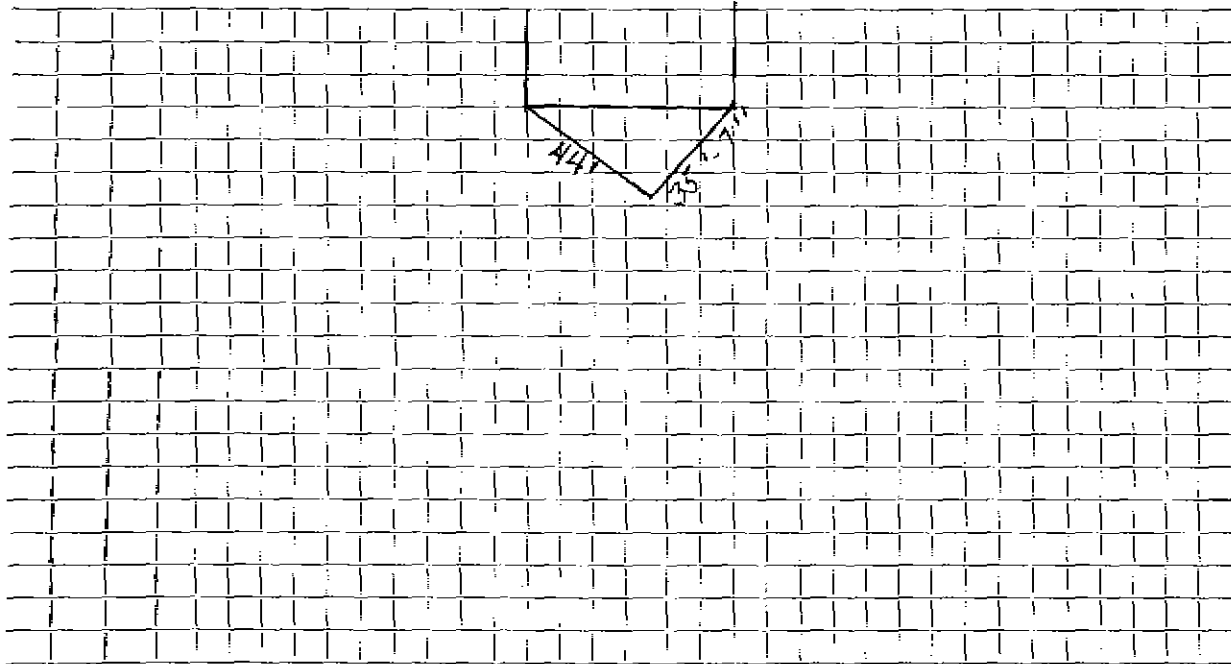

Connection made in Street. Work completed

Remarks:

.....

.....