

WATER SERVICE RECORD

Name

Service No.

Address 42 Asbury Street

Location

~~Repair~~—Renewal—~~New~~ Service


Date	Material	Amount	Total	Date		Amount
6/4/54	72' 1" COPPER					
	170' 1" COPPER					
	1 1" x 3/4 S+W				NON CHARGE	
	2 1" UNIONS			7-18-60	Labor	27 60
	1 3/4 x 1/2 Bush			26'	1" Copper tubing @ 1/2	10 92
	2 BAGS ROCK WOOL			1	1" G Corp cock	4 91
				1	1" S Curb cock	6 28
				1	Box & Rod	1 90
				2	Hrs. Pippin shovel @ 1.50	9 00
				1	Hr. Trucking @ 3.00	3 00
						66 61

DATE _____

TOWN OF LEXINGTON — BOARD OF PUBLIC WORKS

WATER DIVISION

Sketch of Service Here

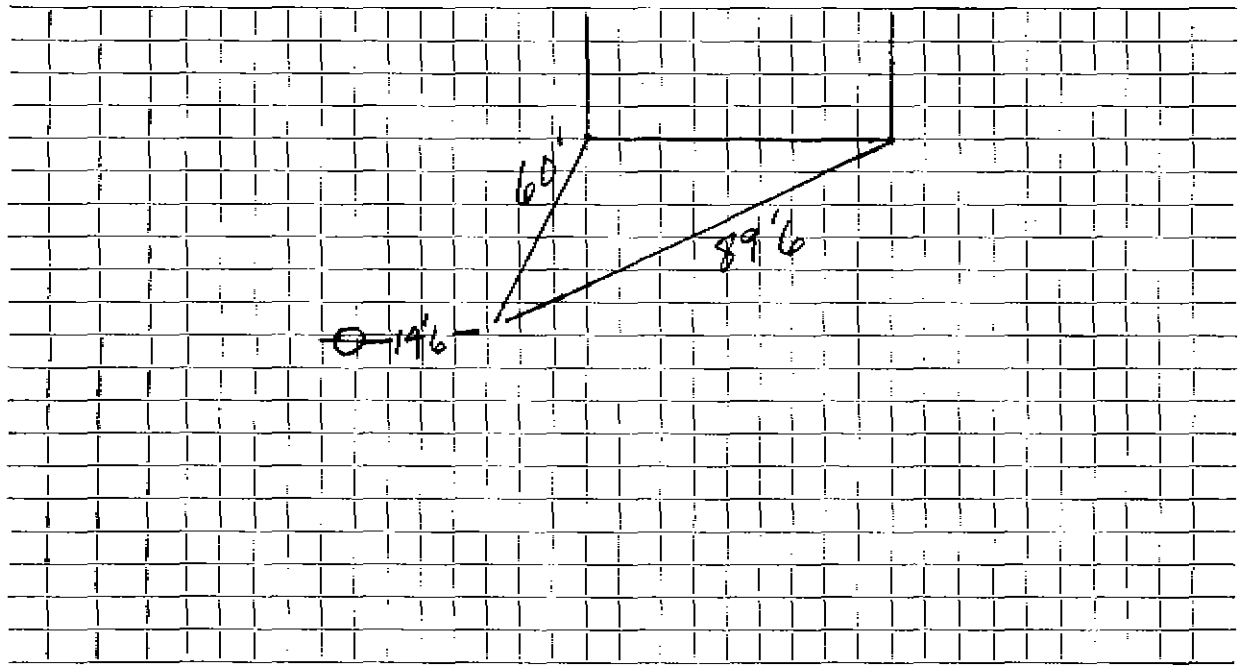

Connection made in Street. Work completed

Remarks:
.....
.....