


DATE 8/14/53

TOWN OF LEXINGTON — BOARD OF PUBLIC WORKS
WATER DIVISION

Sketch of Service Here

1/2 ASHOKY

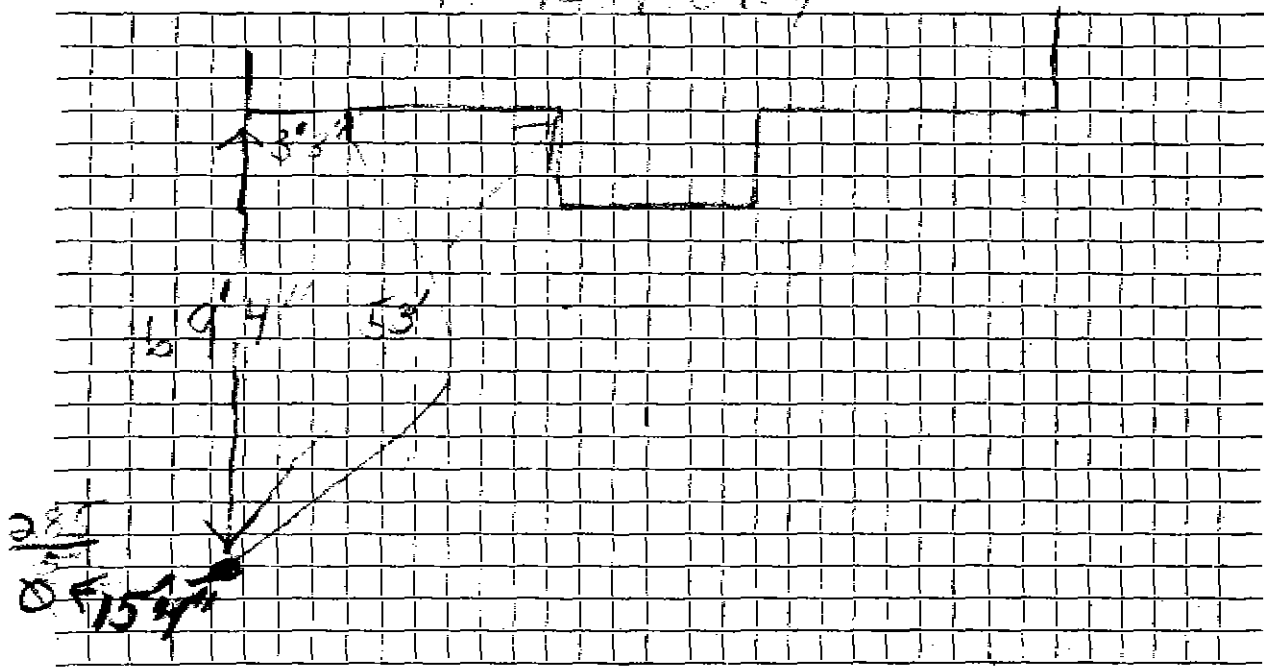

Connection made in Street. Work completed

Remarks: all 3' c.u.