

WATER SERVICE RECORD

#1632
#1633

Name William Hamilton
Address 46 Asbury Street

Service No. 200

Location

~~REPAIR WORK~~ - New Service

Comm 11-16-57


Date	Material	Amount	Total	Date	Material	Amount
8-31-59	Labor	3 83		8-28-59	Deposit	35 00
	10% O.E.	38	4 21	12-28-59	Paid	5 13
66'	3/4" Copper tubing @ 41		27 06			40 13
1	3/4" C x 1/2 I.W.H. Stop & Waste		5 84			
1	3/4" C 3 Part Union		2 27		NON-CHARGE	
1	Hr. Trucking @ 75		75		Labor	3 83
			40 13	26'	3/4" Copper tubing @ 41	10 66
				1	3/4" C Corp Cock	4 64
				1	3/4" C Curb Cock	5 94
				1	Box and Rod	5 00
				1	1/2 Straighttail piece	50
				1	1/2 Offsettail piece	50
						31 07

DATE _____

TOWN OF LEXINGTON — BOARD OF PUBLIC WORKS

WATER DIVISION

Sketch of Service Here

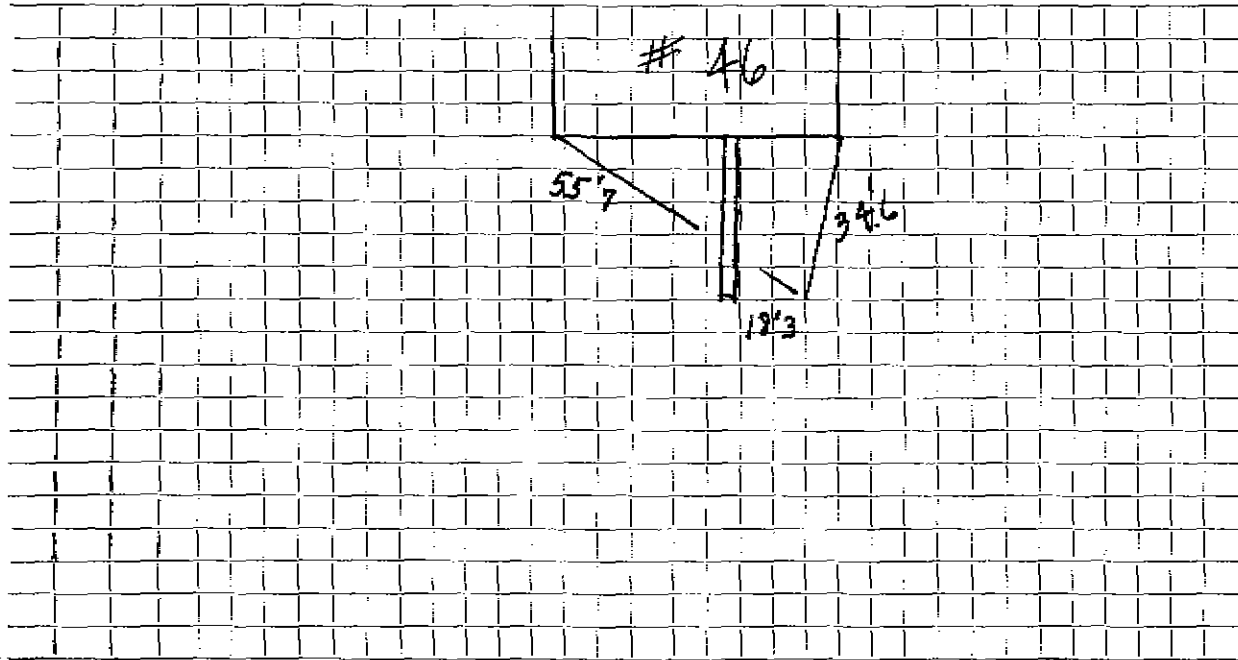

Connection made in Street. Work completed

Remarks:

.....
.....