

WATER SERVICE RECORD

Name Richard Hamilton

Service No. 86

Address 51 Asbury Street

Location

Reason for ~~Record~~ New Service

Comm 7-6-59

Date	Material	Amount	Total	Date	Amount
5-14-59	Labor	2 10		5-12-59	50 00
	10% O.H.	21	2 31	7-6-59	27 54
	37' 3/4" Copper Tubing @ 3666		13 56		<u>22 56</u>
	1 3/4" Cx 1/2 IWH Stop & Waste		5 84		
	1 Hour Trucking @ .75		75		
			22 46		
				22' 3/4" Copper Tubbing @ 3666	8 07
				1 3/4" C Corp Cock	4 64
				1 3/4" C Curb Cock	6 03
				1 Box & Rod	5 00
				1 1/2 Straight Tail piece	50
				1 1/2 Offset Tail piece	50
					26 59

Deposit
Retained


NON CHARGE

TOWN OF LEXINGTON — BOARD OF PUBLIC WORKS

WATER DIVISION

DATE _____

Sketch of Service Here

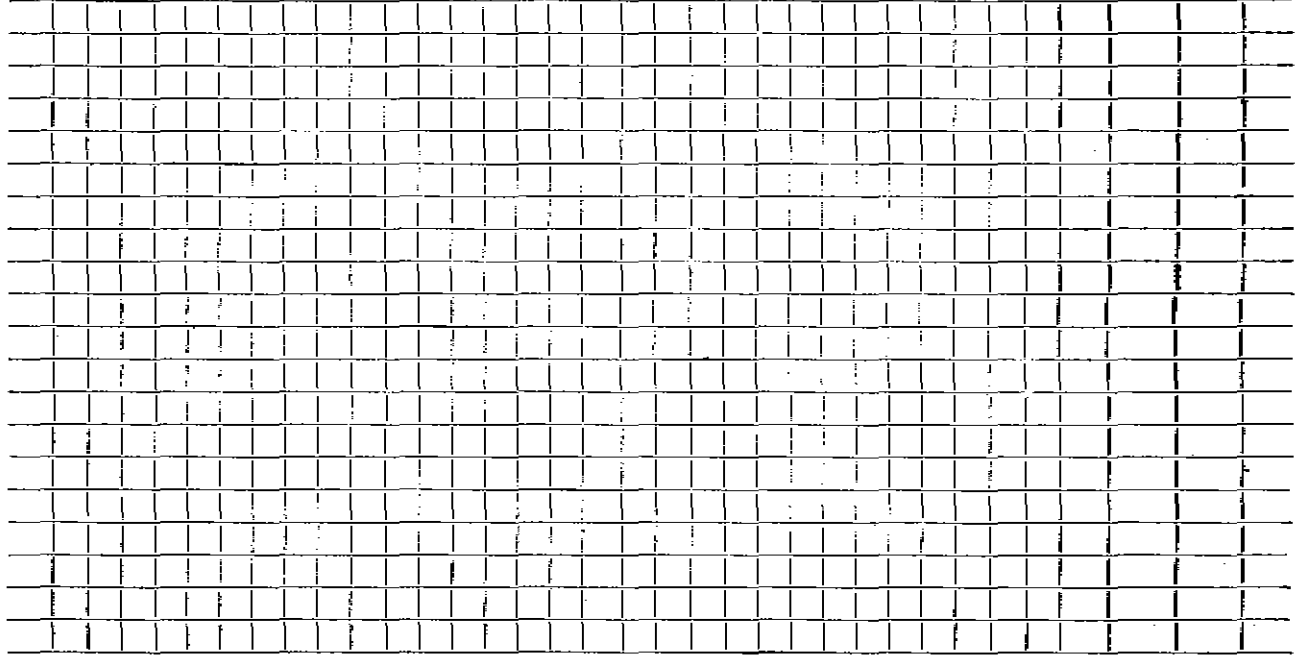

Connection made in _____

Street _____

Work completed _____

Remarks: _____

