




TOWN OF LEXINGTON — BOARD OF PUBLIC WORKS

WATER DIVISION

TIES 58 ASBURY STREET

Sketch of Service Here

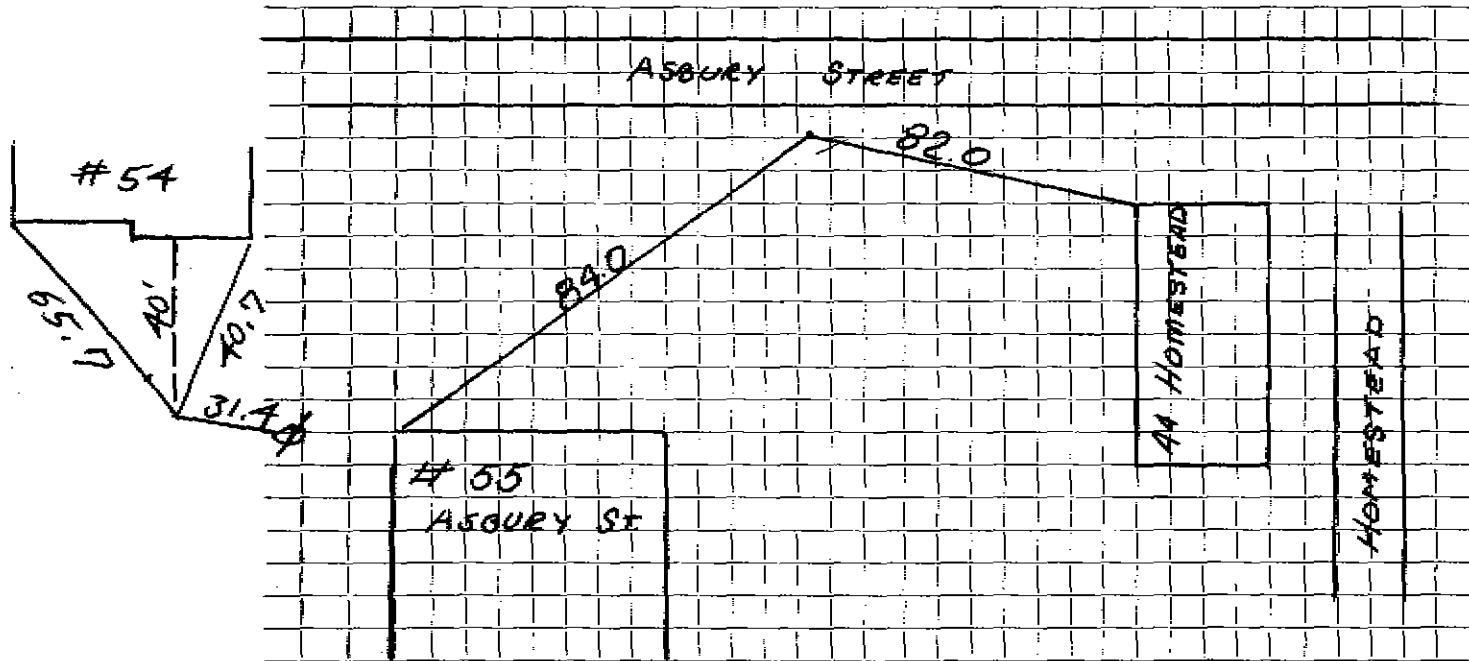

Connection made in ..... Street. Work completed .....

Remarks: .....

.....

.....