

**WATER SERVICE RECORD**

Name **Richard D. Hamilton**

Service No. **102**

Address **55 Asbury Street**

#4648

Location

~~Worked on~~ **New Service**


*Comm 6-22-59*

Date	Material	Amount	Total	Date		Amount
5-27-58	Labor	1.95		5-26-59	Deposit	51.00
	10% O.H.	.20	2.15	6-14-59	Returned	25.86
	42' 3/4" Copper tubing @.3666		15.40			21.14
	1 3/4" C x 1/2 I.W.H. Stop & Waste		5.84		NON CHARGE	
	1 hr. Trucking @.75		.75		Labor	1.85
			24.14			
				13'	3/4" Copper Tubing @.3666	4.77
				1	3/4" C Corp. Cock	4.64
				1	3/4" C Curb Cock	6.03
				1	Box & Rod	5.00
				1	1/2 Straight Tailpiece	.50
				1	1/2 Offset tailpiece	.50
						23.29

**TOWN OF LEXINGTON — BOARD OF PUBLIC WORKS**  
**DATE**

**WATER DIVISION**

Sketch of Service Here

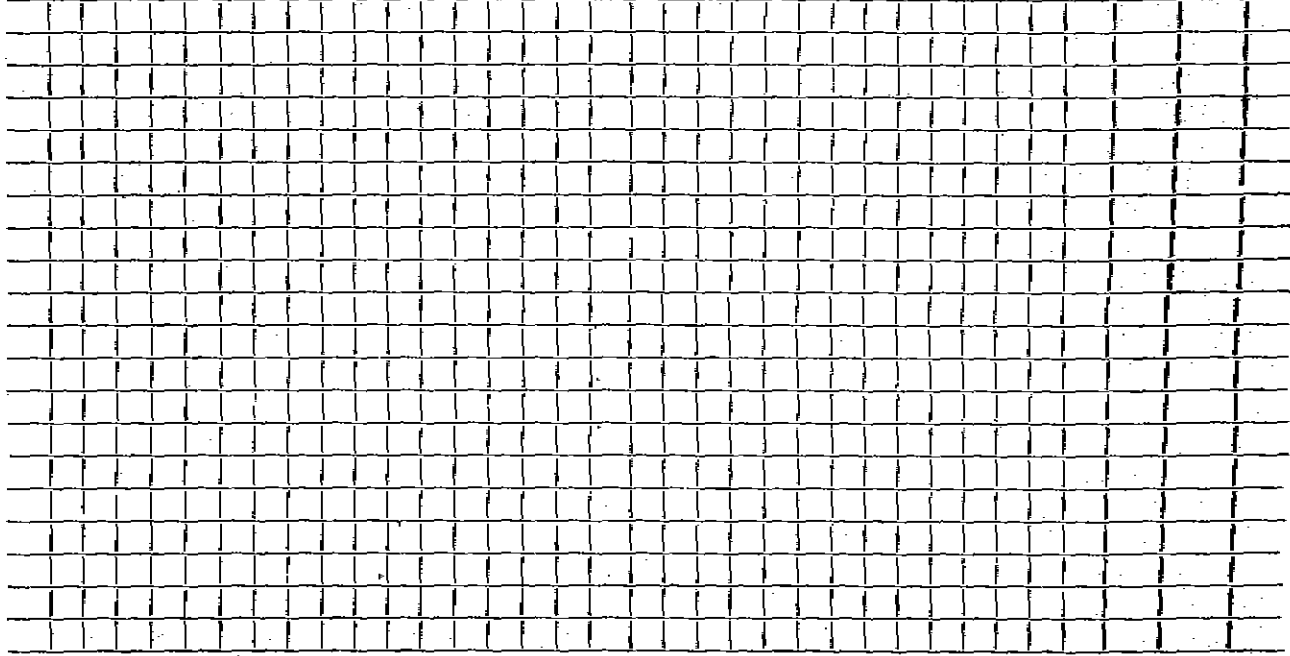

Connection made in

Street

Work completed

Remarks: