

WATER SERVICE RECORD

Name **Tricorn Homes**

Service No. **3**

Address **64 Asbury Street**

Lots **253 - 249**

# **1625**

Location

Repair—Renewal—New Service **WO # 8534**

**COMM 51864**


Date	Material	Amount	Total	Date	Material	Amount
4-2-64	Labor	2 31		1-30-44	Deposit	50 00
	10% O.H.	23	2 54	5-18-44	* Returned	13 29
	55' 3/4" Copper tubing @ .42		23 10			36 21
	1 3/4" CX 1/2 I.W.H. Stop & Waste		6 17		NON CHARGE	
	1 Curb Box & Rod		4 90	8-6-60	Labor	1 94
			36 71		35' 3/4" Copper tubing @ .42	14 70
					1 3/4" C Corp Cock	4 91
					1 3/4" C Curb Cock	6 28
					1 Box & Rod	4 90
						32 73
				4-2-64	1 1/2 Straight Tailpiece	50
					1 1/2 Offset Tailpiece	50
						33 73
* Applied to SK <del>1625</del>						

DATE \_\_\_\_\_

# TOWN OF LEXINGTON — BOARD OF PUBLIC WORKS

## WATER DIVISION

Sketch of Service Here

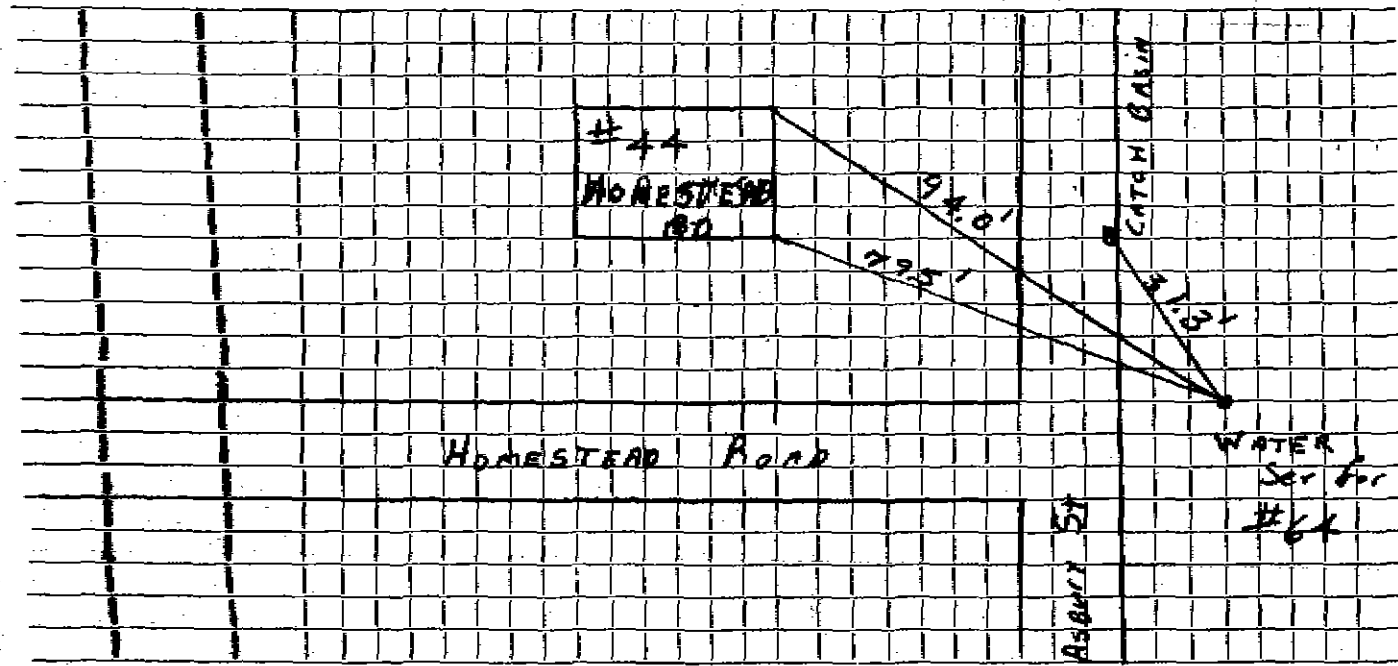

Connection made in \_\_\_\_\_ Street. Work completed \_\_\_\_\_

Remarks: \_\_\_\_\_  
\_\_\_\_\_  
\_\_\_\_\_