

WATER SERVICE RECORD

Name Leland Const. Co.

Service No. 9

Address 7 Ashbury Street

2559

Location Lexington

~~Repair -~~ New Service

COM. 2-16-53

Date	Material	Amount	Total	Date	Amount
1/16/53	Labor	3 07		1-16-53 Deposited	20 00
	10% overhead	31	3 38	2-16-53 Refunded *	(11 87)
	1 -3/4" C x 1/2 I.W.H. stop & waste	4 00	4 00	<u>NON CHARGE</u>	8 13
	1 hr. trucking		75	1/16/53 Labor	3 07
			8 13	35' -3/4" copper tubing @ .34	11 90
	TRENCH DUG BY OWNER:			1 -3/4" C. curb-cock	4 33
	PIPE SUPPLIED & LAID BY OWNER:			1 -3/4" C x 3/4" C. curb-cock	4 67
				1 box and rod	3 90
				1 -1/2 offset tail pc.	50
				1 -1/2 straight tail pc.	50
				1 hr. trucking	75
					<u>29 62</u>


* \$3.68 made payable to L. G. Co.
to apply as follows:
#184 apply on meter #11
1.84 " " " #13

DATE _____

TOWN OF LEXINGTON — BOARD OF PUBLIC WORKS

WATER DIVISION

Sketch of Service Here

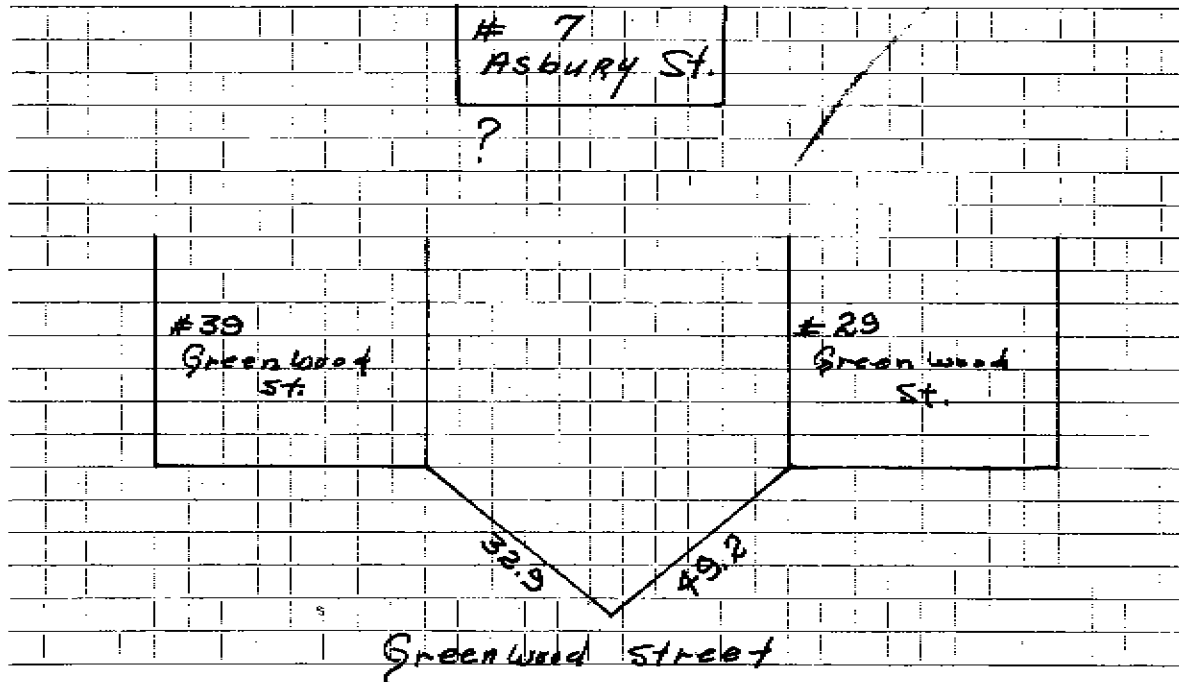

Connection made in Street. Work completed

Remarks:

.....

.....