

## WATER SERVICE RECORD

Name Custance Bros.

Service No. 4

Address 72 Asbury Street

Location

~~WATER SERVICE~~ New Service W.O. #8546

MAR 23 1964


Date	Material	Amount	Total	Date	Amount
2-28-64	Labor	4 73		1-28-64	100 00
	10% O.H.	47	5 20	3-23-64	54 41
	70 3/4" Copper tubing @.42		29 40		45 59
	1 3/4" CX 1/2 I.W.H. Stop & Waste		6 17		
	2 3/4" C3 Part Unions @2.41		4 82		
			45 59	2-28-64	1 1/2 Straight Tailpiece
					1 1/2 Offset Tailpiece
					50
					50
					1 00
	<u>REPAIR</u>				
4/29/65	Labor	3 05			
	10% O. H.	31	3 36		
	6" 3/4" Copper tubing @ .42		2 52		
	2 3/4" Style 88 clamps @ 2.90		5 80		
	1 Hr. Trucking @ 3.00		3 00		
			14 68		

DATE \_\_\_\_\_

TOWN OF LEXINGTON — BOARD OF PUBLIC WORKS

**WATER DIVISION**

Sketch of Service Here

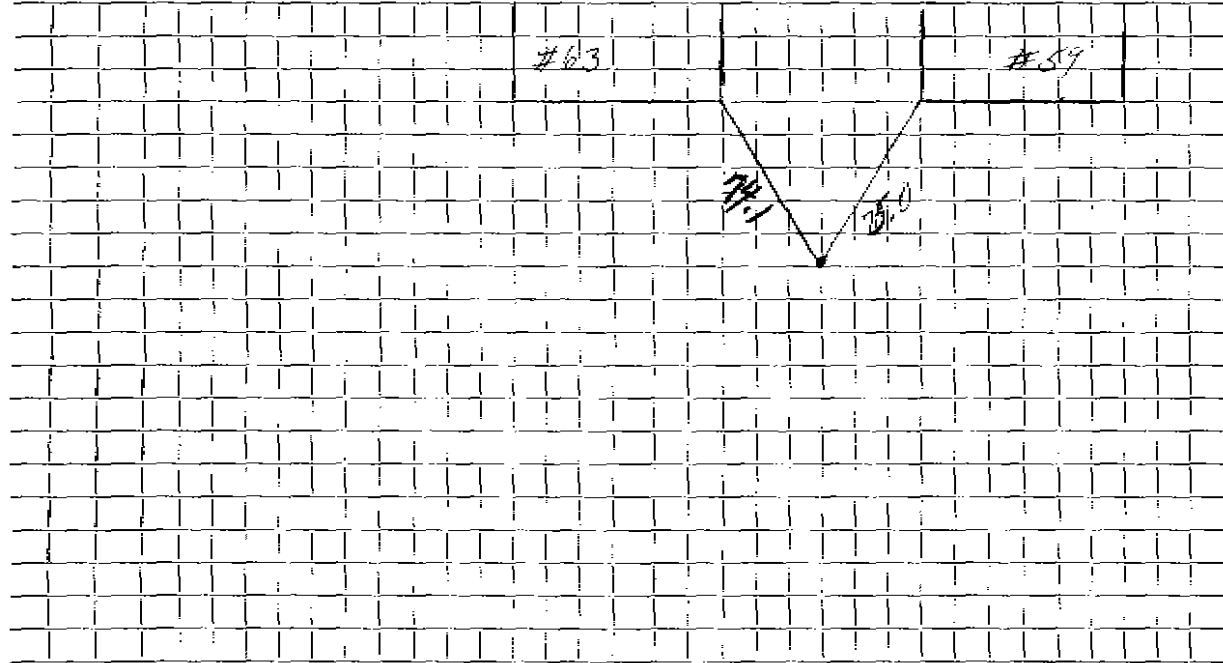

Connection made in ..... Street. Work completed .....

Remarks: .....

.....

.....