

# 4471

WATER SERVICE RECORD

Name Keith Barnhill

Service No. 61

Address 6 Ash Street

# 7762

Location

~~Repair~~ New Service W.O. #8050

Comm 10-28-63


Date	Material	Amount	Total	Date		Amount
7/2/63	Labor	4 62		6-29-63	Deposit	100 00
	10% Overhead	46	5 08	10-28-63	Refund	56 55
	60' 3/4" Copper tubing @ .42		25 20			43 45
	1 - 3/4" Cx 1/2 I.W.H. Stop & Waste		6 17		NON CHARGE	
	1 hr. Trucking		3 00	7/2/63	Labor	19 86
	4x3 Patch		4 00		12' 3/4" Copper tubing @ .42	5 04
			43 45		1 - 3/4" C. Corp Cock	4 91
					1 - 3/4" C. Curb Cock	6 28
	(OWNER DUG TRENCH)				1 Box & Rod	4 90
					1 - 1/2 Straight Tailpiece	50
					1 - 1/2 Offset Tailpiece	50
					1 hr. Town Shovel	6 50
						48 49

DATE \_\_\_\_\_

# TOWN OF LEXINGTON — BOARD OF PUBLIC WORKS

## WATER DIVISION

Sketch of Service Here

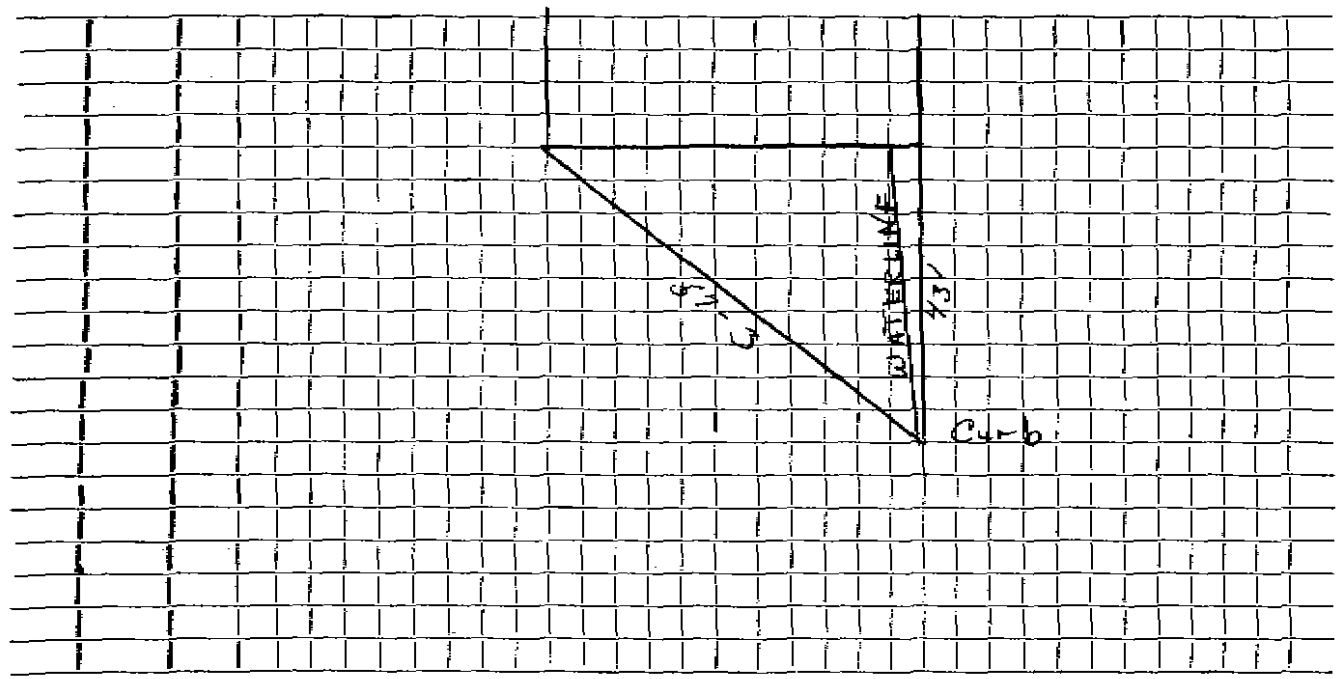

Connection made in ..... Street. Work completed .....

Remarks: .....  
.....  
.....