


DATE 12/2/07

TOWN OF LEXINGTON — BOARD OF PUBLIC WORKS
WATER DIVISION

Sketch of Service Here

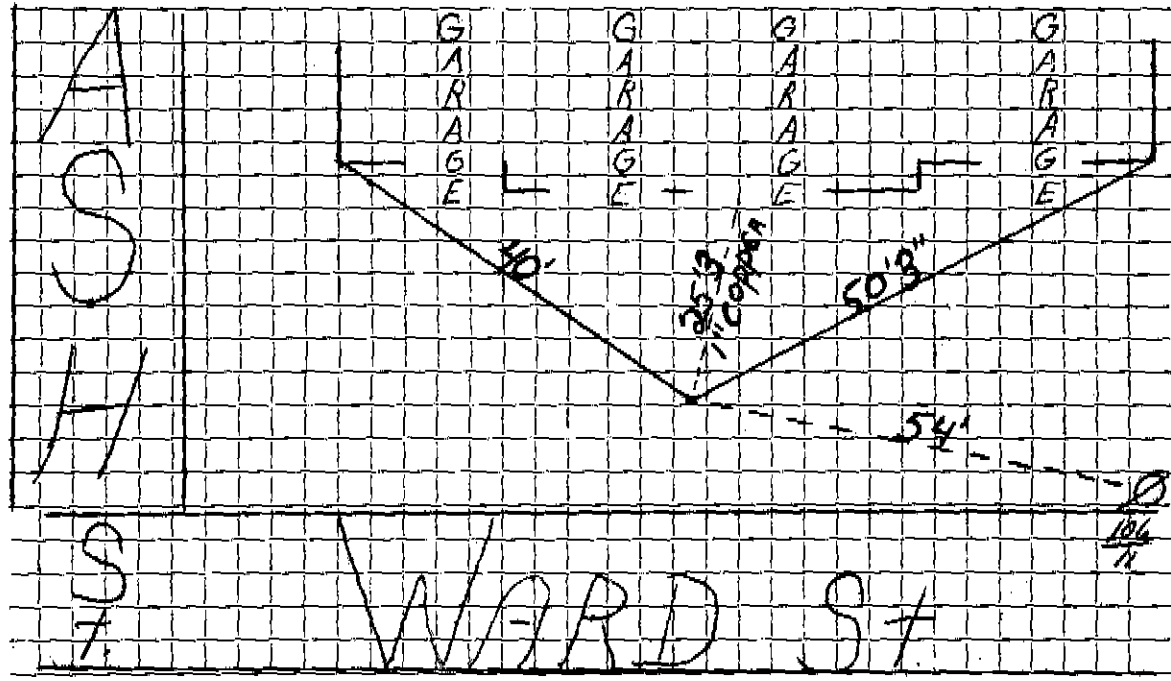

Work made in Street. Work completed

Notes: