




DATE \_\_\_\_\_

TOWN OF LEXINGTON — BOARD OF PUBLIC WORKS

WATER DIVISION

Sketch of Service Here

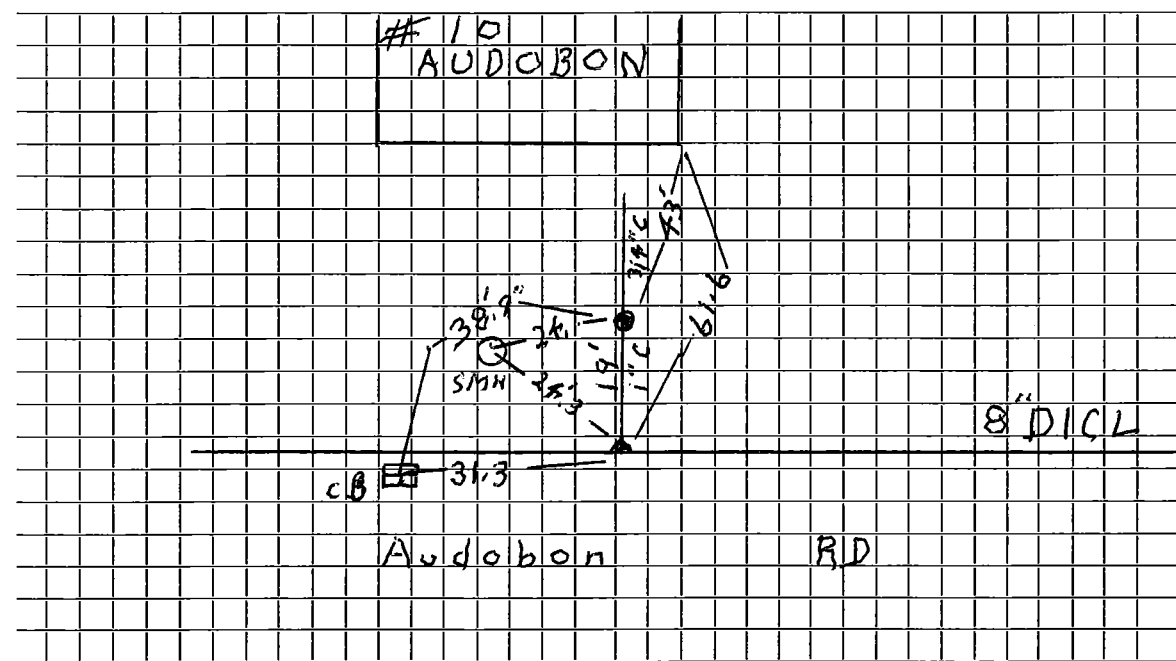

Connection made in ..... Street.

Work completed 10/25/10 G. r. e. a. n. e. s. e. ....

Remarks: .....  
.....  
.....