




DATE \_\_\_\_\_

# TOWN OF LEXINGTON — BOARD OF PUBLIC WORKS

## WATER DIVISION

Sketch of Service Here

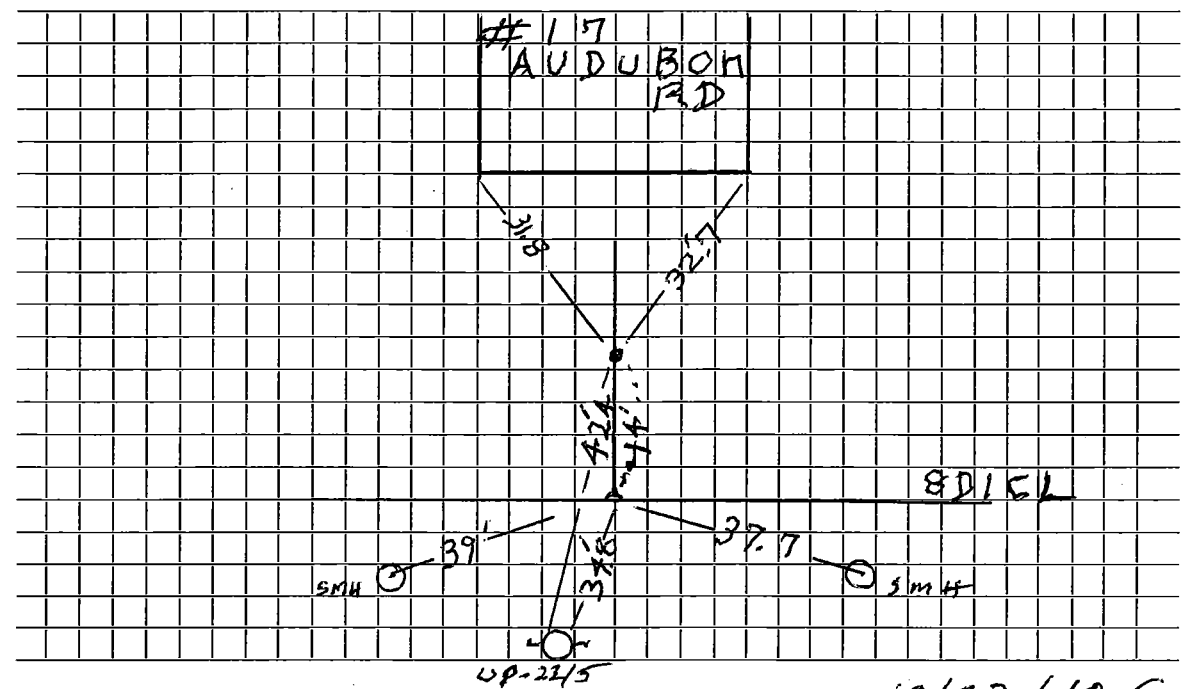

Connection made in ..... Street.

Work completed 10/22/10 Grane...

Remarks:.....  
.....  
.....