




DATE \_\_\_\_\_

TOWN OF LEXINGTON — BOARD OF PUBLIC WORKS  
**WATER DIVISION**

Sketch of Service Here

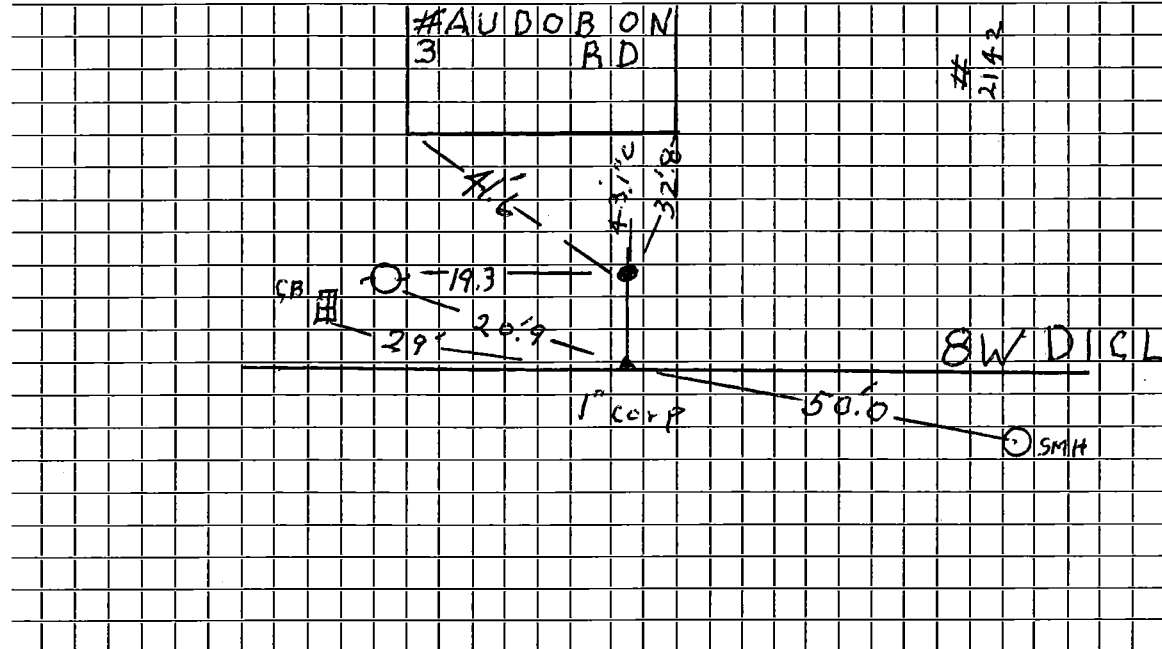

Connection made in AUDOBON Street. Work completed OCT 2010

Remarks: .....

.....

.....