WATER SERVICE RECORD


Service No.

19 Augustus Road dien May Service Pond Realty Total Date Material Amount 99' 3/4"Copper tubing 34 Comp Unions 2 1' Copper

DATE____

TOWN OF LEXINGTON - BOARD OF PUBLIC WORKS

WATER DIVISION

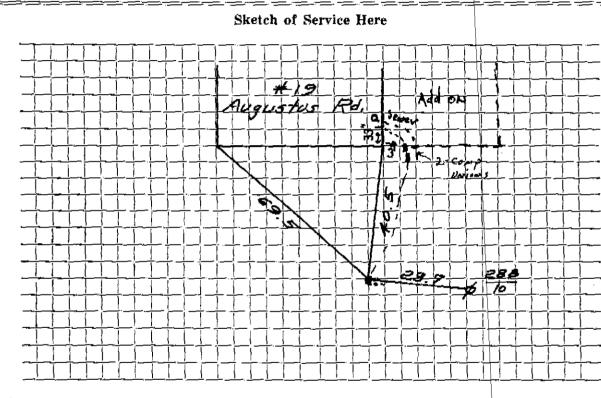

Connection	: made in	Street.	Work completed	
Remarks:	Union Under Footin	Ş	_	