

WATER SERVICE RECORD

Name L. H. Hewett Jr. Inc.

Service No. 30

Address 10 Avon Street

Location

~~REPAIRS-RENEWAL~~ REPAIRS-RENEWAL - New Service Hewett #3484 W.O.#835

JUL 7 198

Date	Material	Amount	Total	Date	Amount
-2-79	Labor	12.50		10-20-79	25.00
	10% O.H.	1.25	13.75	7-7-81	136.00
	1 hr. Trucking		3.00		386.00
10-1-79	37' 1" Copper tubing @	10.00	370.00		
			386.75		

Deposit
Paid by S/C #88


Bill Paid 136.25

DATE _____

TOWN OF LEXINGTON — BOARD OF PUBLIC WORKS

WATER DIVISION

Sketch of Service Here

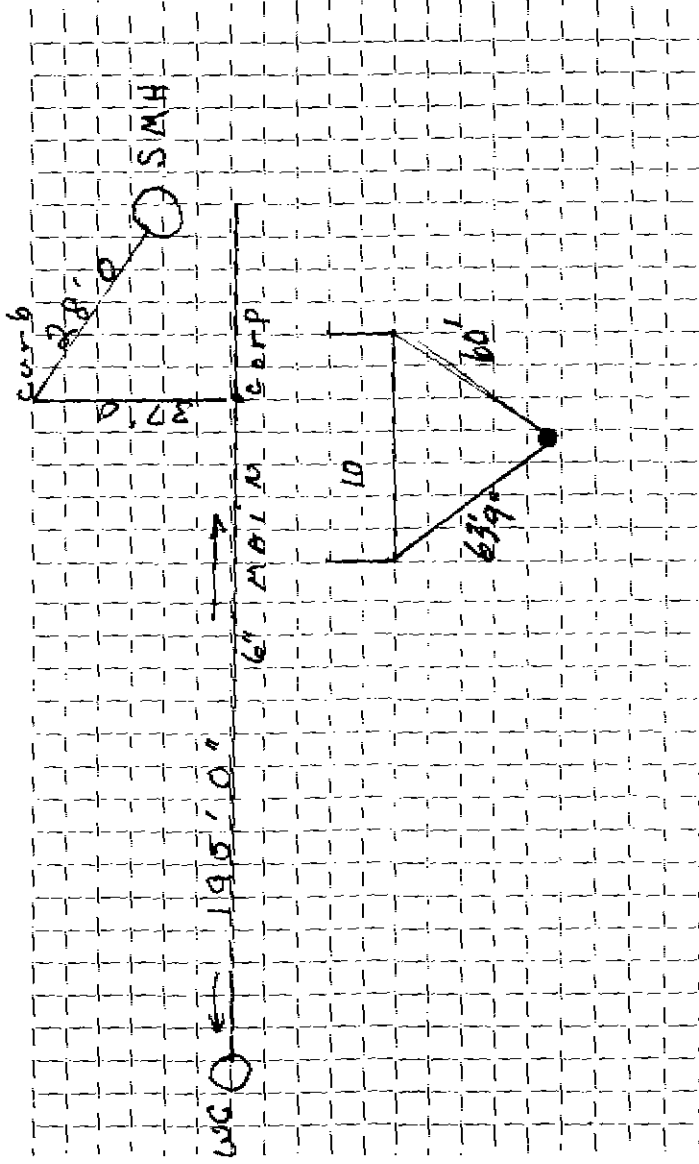

Location made in Street. Work completed

Remarks: