

WATER SERVICE RECORD

Name *George Smith*

Service No.

Address *12 Avon Street*

Location

~~Supply~~ Renewal ~~New Service~~ James Redmond #3635


Date	Material	Amount	Total	Date	Amount
10/81	30' 6" 3/4" Copper tubing				
	1 3/4" Curb				
OUTSIDE W.O. #1630					
				6/2/81	
	19' 3/4" Copper tubing				
	1 L.L. to copper adapter 3/4"				
	2 hrs. Trucking				
	3 hrs. Town Shovel				

DATE _____

TOWN OF LEXINGTON — BOARD OF PUBLIC WORKS

WATER DIVISION

Sketch of Service Here

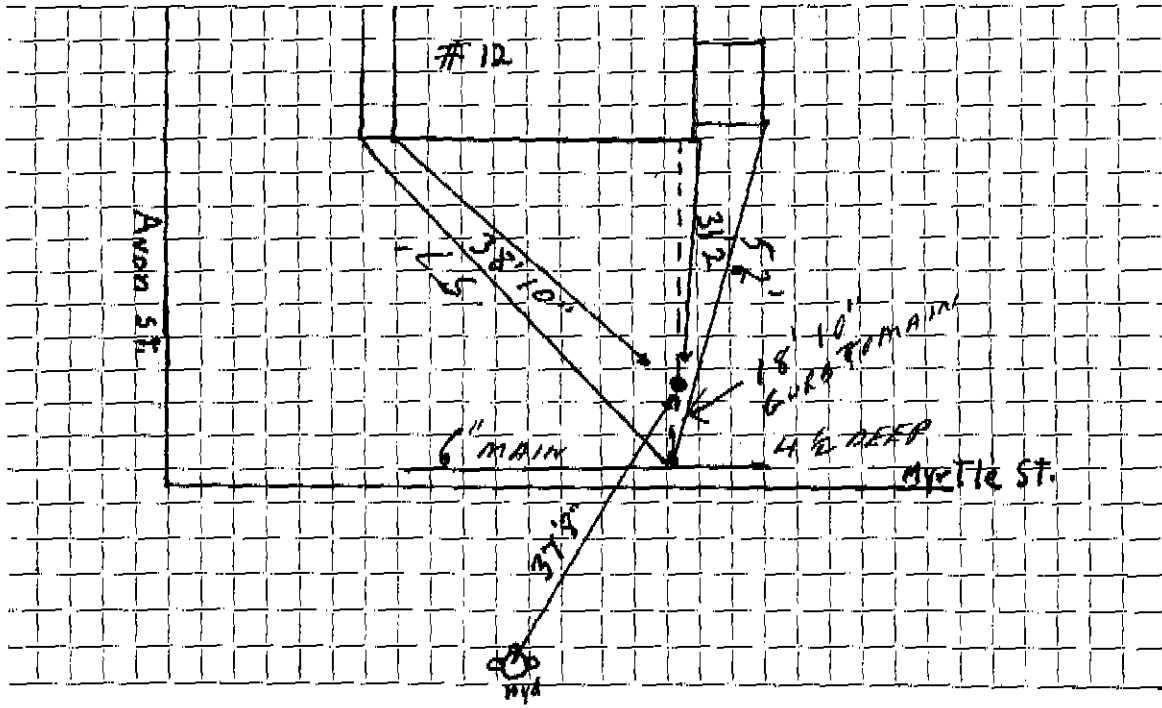

Injection made in Street. Work completed

marks:

.....
.....