

## WATER SERVICE RECORD

Name

Service No.

Address 17 Avon Street

# 2558

Location


Repair—Renewal—New Service Lower Service

Date	Material	Amount	Total	Date	Amount
7/63	Labor	30 29			
	10% O.H.	3 03	33 32		
39'	3/4" Copper tubing @ .42		16 38		
1	3/4" Cx 1/2 I.W.H. Stop & Waste		6 17		NON CHARGE
1	hr. Trucking		3 00	7/22/63	Labor
3	hrs. Town Shovel @ 6.50		19 50	20'	3/4" Copper tubing @ .42
			78 37	1	3/4" C. Curb Cock
	RENEWED OUTSIDE BY TOWN			1	3/4" C. Corp Cock
1/86	60' 1" Copper			1	Box & Rod
1	1" Corp.			1	1/2" Straight tailpiece
1	1" x 3/4" Reducer			1	1/2" Offset tailpiece
12'	3/4" Copper			1	hr. Town Shovel
1	3/4" x 3/4" Tee			2	hrs. Town Truck @ 3.00
1	3/4" 3 Part Union				

DATE \_\_\_\_\_

TOWN OF LEXINGTON — BOARD OF PUBLIC WORKS  
**WATER DIVISION**

Sketch of Service Here

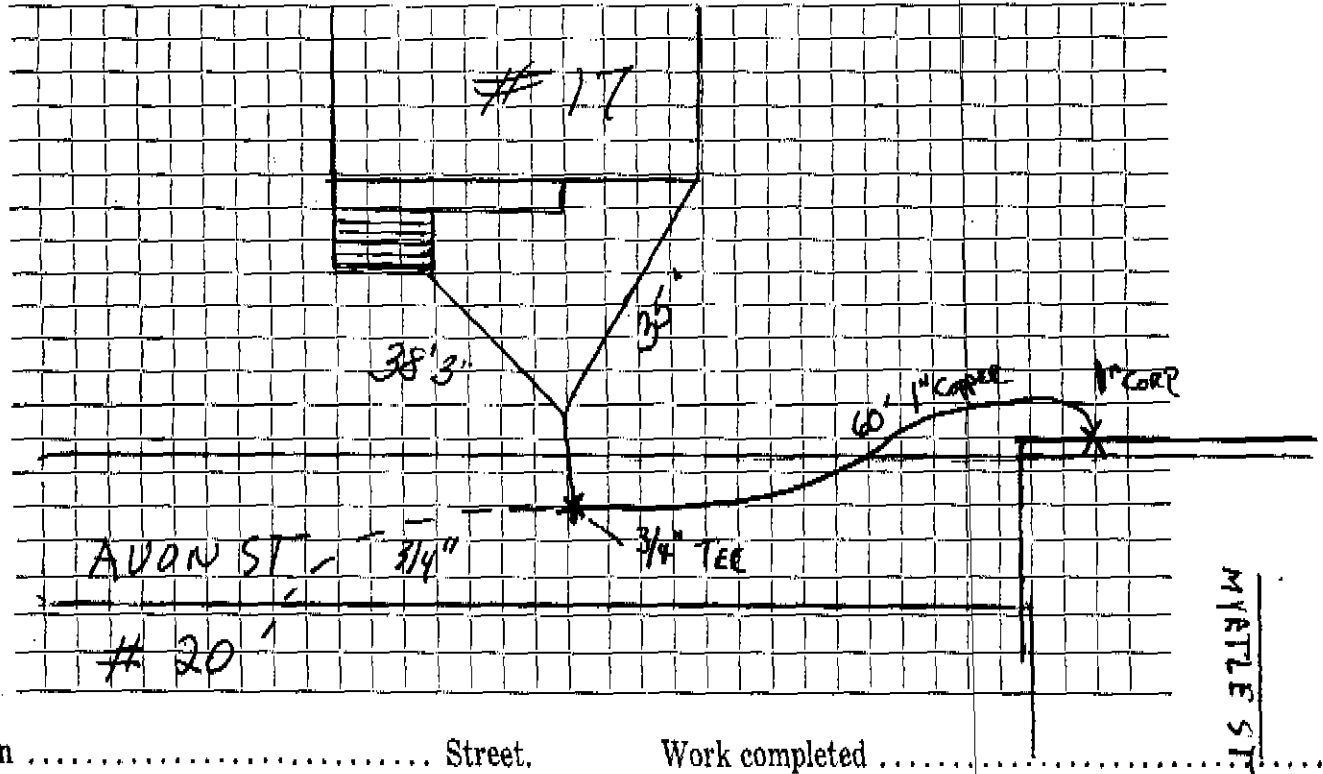

Connection made in ..... Street. Work completed .....

Remarks: .....  
.....  
.....