



DATE 1/10/1917

# TOWN OF LEXINGTON - BOARD OF PUBLIC WORKS

## WATER DIVISION

The undersigned applies for a supply of water at No. 5000 St. and hereby agrees to comply with the rules and regulations as now, or at any future time, established by the Board of Selectmen.

Am't. of Estimate \$ 9.00


Owner Wm. M. ...

Am't. Paid \$           

Address 211 ...

Builder                     

Sketch of Service Here

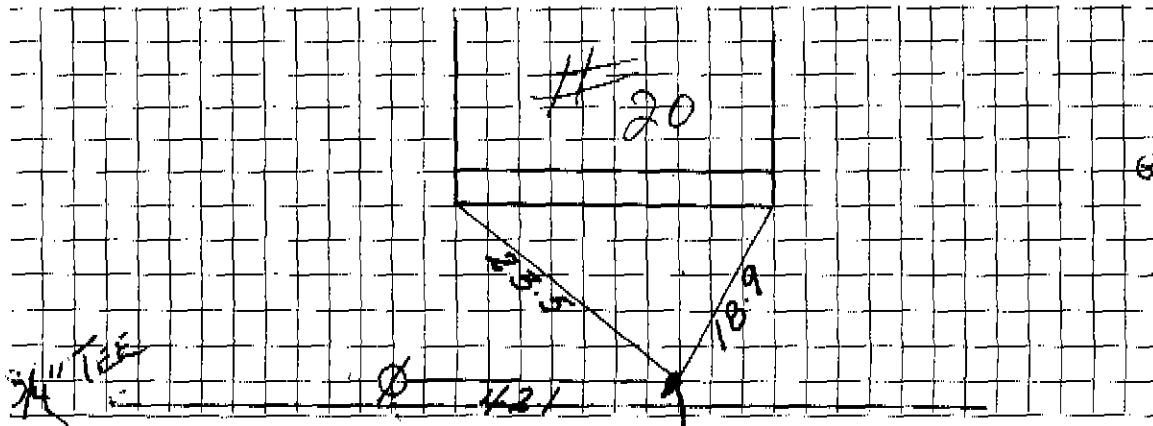

NEW 3/4" COPPER  
GOES UNDER  
6" MAIN

Connection made in           

Street.

Work completed           

19

Remarks:

3/4" 3 pt. union

