

Name

Service No. 60

Address

Location

Avon St.

Kind of Pipe

Size

Size of Main

Repair—Renewal—New Service

Location

Date

Material

Amount

Total

Date

Amo

Labor

DATE _____

TOWN OF LEXINGTON — BOARD OF PUBLIC WORKS

WATER DIVISION

The undersigned applies for a supply of water at No. _____ St. and hereby agrees to comply with the rules and regulations as now, or at any future time, established by the Board of Selectmen.

Amount of Estimate \$ _____


Owner Featando

Amount Paid \$ _____

Address Avon St.

Builder _____

Sketch of Service Here

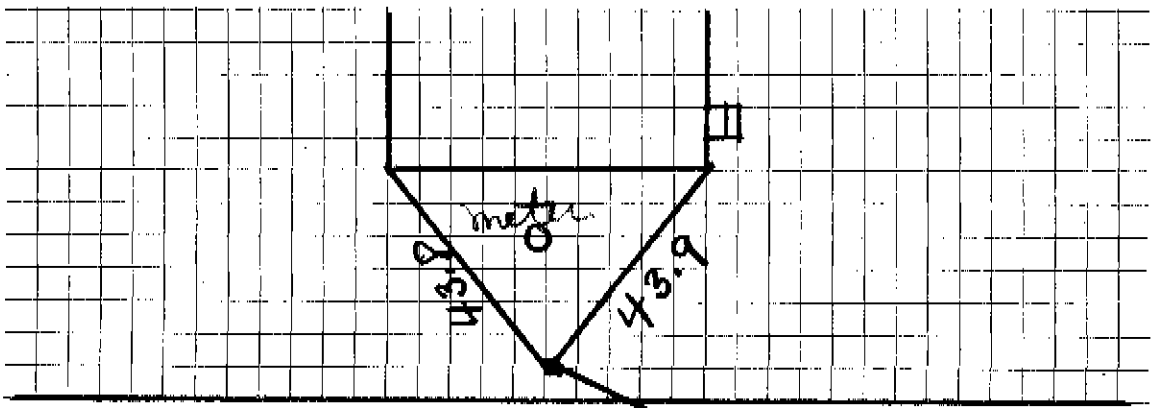

Connection made in Avon Street St. 385 Work completed _____ 19 _____

Remarks: pole