


DATE 15 MARCH 1995

TOWN OF LEXINGTON — BOARD OF PUBLIC WORKS

WATER DIVISION

Sketch of Service Here

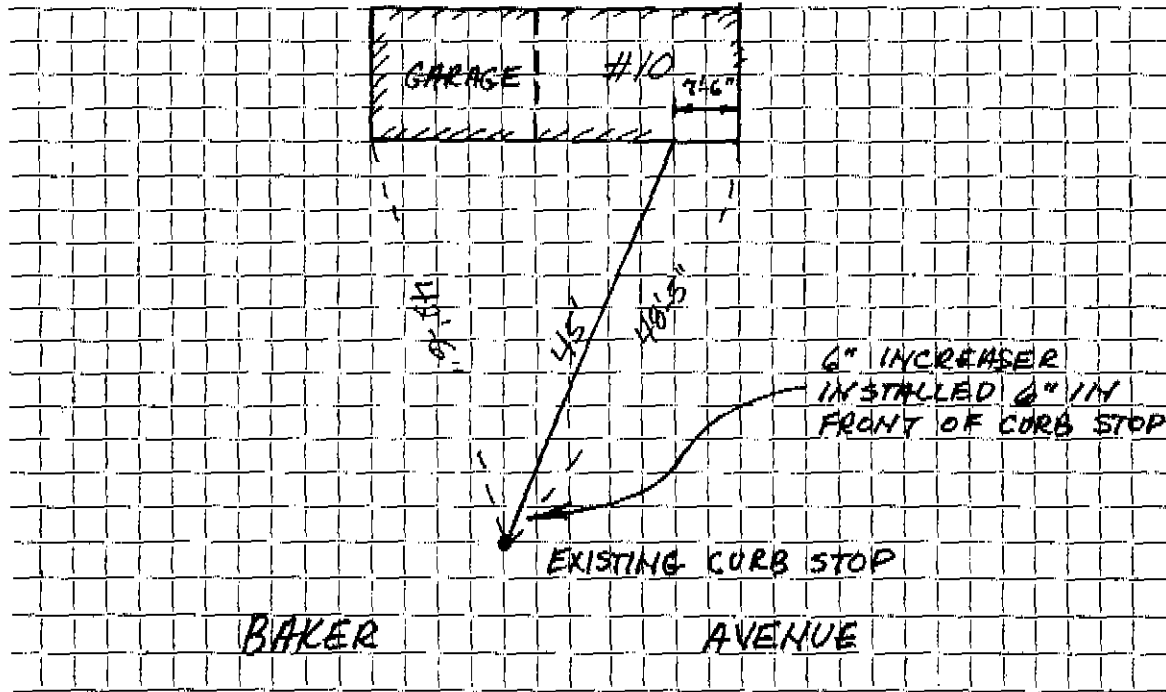

Location made in BAKER AVENUE Street. Work completed J.M. McLAUGHLIN

Remarks:

BOOK 96A

J.M.