
Name			Service No.	Service No.			
Add	dress	24 Baker Avenue					
Loc	ation			 -			
Rej	AKK.	Renewal New Service	W.O.1296				
Date	B	Material	Amount	Total	Date		Amount
/85	915	" 3/4" Copper			-		
	1	3/4" Corp. Adapter	Med.			·	
	1	3/4" Curb	<u></u>	ļ. · ··-	<u> </u>		
	1	1" L.L. Coupling				<u> </u>	
	1	1" x 4" C.L. Nippl	e				
	1	1" St <u>yle 138</u>		<u> </u>			
				<u> </u>		<u></u>	
					· · · · · · · · · · · · · · · · · · ·	,	
				 			
	.			 		· · · · · · · · · · · · · · · · · · ·	
			+		<u> </u>		
		· · · · · · · · · · · · · · · · · · ·			-	<u> </u>	
	-+					······································	
	\perp		ļ	· · · · · · · · · · · · · · · · · · ·			
	_			:	<u> </u>	<u></u> .	i

DAT	E	

TOWN OF LEXINGTON - BOARD OF PUBLIC WORKS

WATER DIVISION

Sketch of Service Here

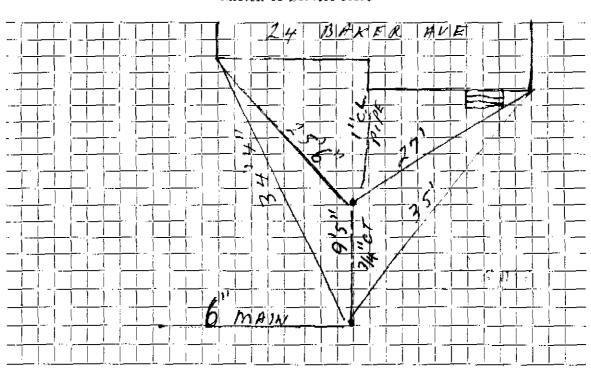

mection made in	Street.	Work completed

narks: