

### WATER SERVICE RECORD

Name Mark Moore, Jr. Service No. 196

Address 28 Baker Avenue

Location

~~REPAIR~~ - Renewal - ~~NEW SERVICE~~

*Conn. 11-F-54*

Date	Material	Amount	Total	Date	Material	Amount
4/54	Labor	14 40		2-20-54	Deposited	40 00
	10% overhead	1 44	15 84	11-8-53	Refunded	(38 84)
	23' - 3/4" copper tubing@ .35		8 05		<u>NON CHARGE</u>	36 72
	1 - 3/4"C x 1/2 I.W.H. stop& waste		4 00	10/4/54	Labor	14 00
	1 hr. Littlefield shovel		7 50		12' - 3/4" copper tubing@ .35	4 00
	1 hr. trucking		75		1 - 3/4"C. adapter	1 00
			36 14		1 - 3/4"C. curb-cock	4 00
					1 - box and rod	3 00
					1 - 1/2 offset tail piece	5 00
					1 - 1/2 straight tail piece	5 00
					1/2 hr. Littlefield shovel@7.50	3 75
					1 hr. trucking	75
					patching 10x3	10 00
						44 00


DATE \_\_\_\_\_

# TOWN OF LEXINGTON — BOARD OF PUBLIC WORKS

## WATER DIVISION

Sketch of Service Here

28

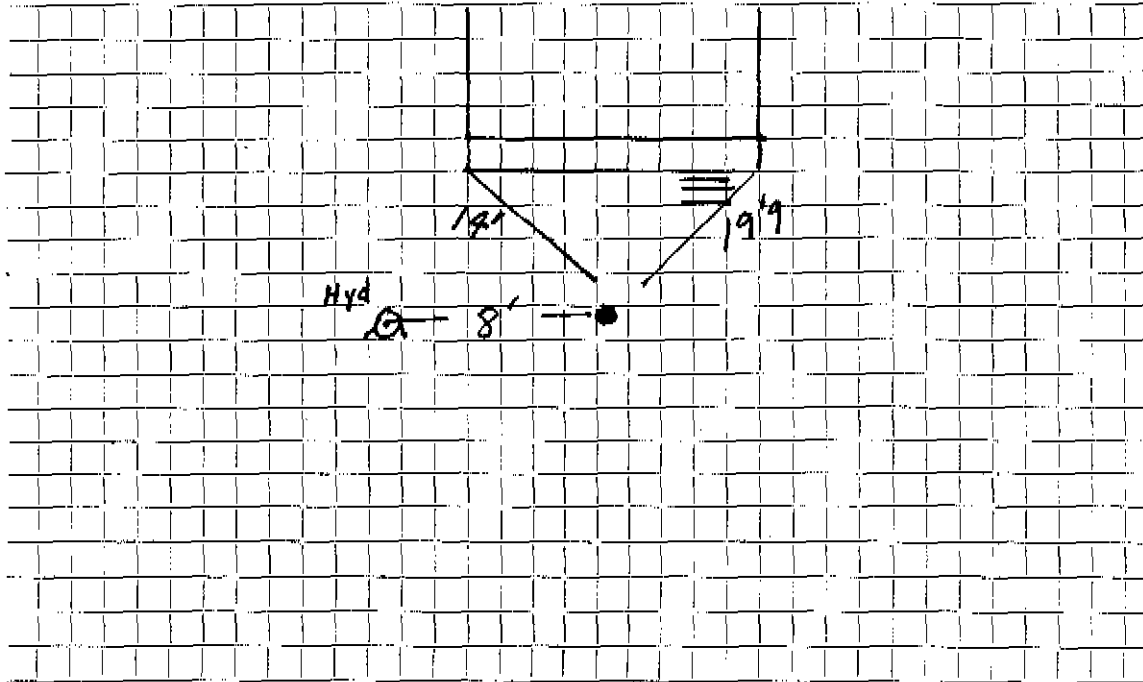

Connection made in ..... Street. Work completed .....

marks: .....

.....

.....