

Name Joseph L. McDonald  
 3 Baker Ave  
 Address ~~100 Lewis Road Belmont~~

Service No. 2763

Location ~~100 Lewis Road Belmont~~ Cor. Baker & Taft

Kind of Pipe Size Size of Main

~~Repair~~ ~~Renewal~~ New Service

Location

Date	Material	Amount	Total	Date		
✓ 32	1" C.L. Pipe @ .27	8 64				
1	1" L.L. Ell. @ .30	30				
2	1" L.L. Coup. @ .25	50				
1	1" Brass Nipple	25				
1	S & W	3 00				
	Trucking	75	14 19	1/19/55	Labor	5
	Constr. Charge		3 75			
4/27/28	25 Hrs. Labor @ .55	13 75			20' 3/4" copper tubing @ .35	
2	" " @ .60	1 20	14 95		1 3/4" C. adapter	
					1 3/4" C. curb cock	
					1 Box & Rod	
					8 Hrs. Littlefield shoves @ 7.50	6
	15% Overhead		2 24		1 Hr. trucking	
			55 13		patching 12 x 3	1 11
	Labor					
May 10 1928	<i>Return</i>		87			
			36 00			

Hadley Press, Inc. Lexington

DATE 7/1/19

# TOWN OF LEXINGTON—BOARD OF PUBLIC WORKS

## WATER DIVISION

The undersigned applies for a supply of water at No. 100 Baker Ave St. and hereby agrees to comply with the rules and regulations as now, or at any future time, established by the Board of Selectmen.

Am't. of Estimate \$ 100.00

Owner Robert G. McDonald


Am't. Paid \$ 0.00

Address 100 Baker Ave

Builder \_\_\_\_\_

3 BAKER AVE

Sketch of Service Here

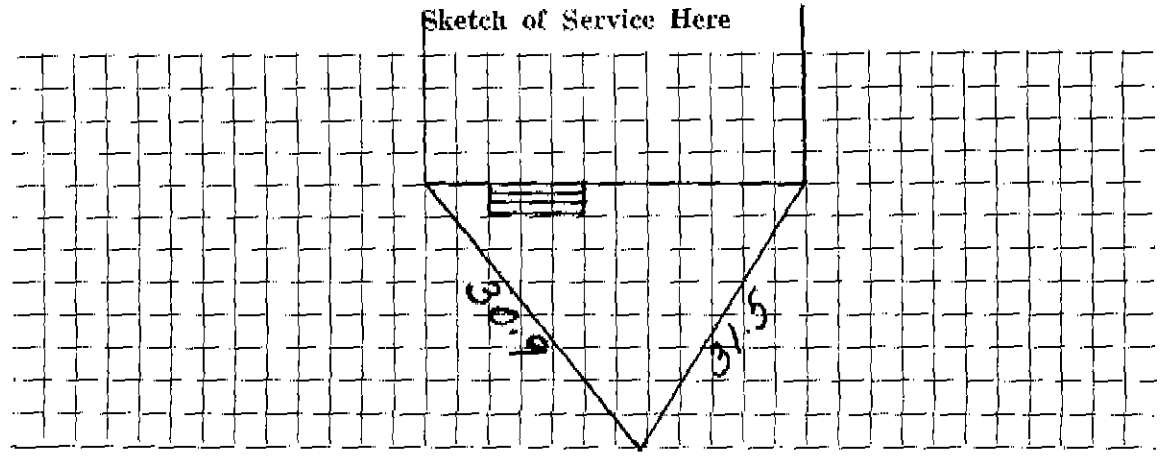

Connection made in \_\_\_\_\_ Street.

Work completed \_\_\_\_\_ 19

marks: