

WATER SERVICE RECORD

Name Timothy Sullivan

Service No. 273

Address 34 Baker Avenue

546

Location

Call 12-31-51

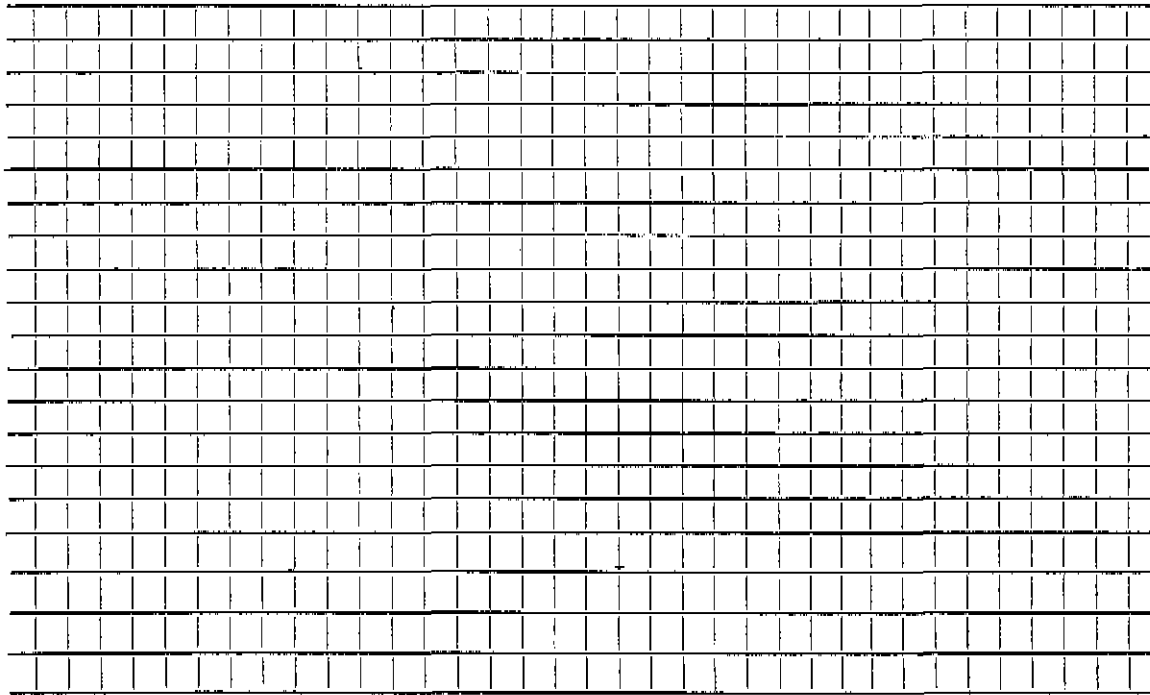
~~Repair~~ ~~Renewal~~ New Service

Date	Material	Amount	Total	Date	Material	Amount
-12-51	Labor	1 49	1 49	10-24-51	Deposited	2 50
	10% Overhead		15	12-31-51	Refunded	(5 50
	40'-3/4" Copper Tubing @.326	13 04	13 04			19 00
	1-3/4" Cx 1/2" I.W.H. S&W		4 00		No Charge	
	1 Hr. Trucking		75	12-12-51	Labor	14 29
	Total		19 43		15'-3/4" Copper Tubing @.326	4 89
					1-3/4" C. Corp-Cock	4 33
					1-3/4" Cx 3/4" C Curb Cock	4 67
					1-1/2" Offset Tail Piece	50
					1-1/2" Straight Tail Piece	50
					1 Hr. Trucking	75
					Total	34 63

DATE _____

TOWN OF LEXINGTON — BOARD OF PUBLIC WORKS
WATER DIVISION

Sketch of Service Here

A large grid of graph paper, consisting of approximately 20 columns and 20 rows of small squares, intended for sketching service details.

Connection made in Street. Work completed

Remarks:

.....

.....