## WATER SERVICE RECORD

#3395

Name
Service No.

Address 37 Baker Avenue
Location

Repair—Renewal—New Service


	- <del></del>					
Date	Material	Amount	Total	Date		Amount
	34 CoppER 3/4 Corb			#		
	3/4 Corb		 	╿   <del>  </del>	 	
	BOX LROS		 ,	╵╵ ╾╂╁╶╌═╌╴╶╼═╌╴┼╌══╌╶╴	! <del></del>	
			J 	"	<u> </u>	
		<del></del>	, !	·; - <del>  </del> <del></del> <del> </del>	/ <del> </del>	_ <del></del>
		 	/ 	· 	′   <del> </del>	·
			! <del> </del> - <del> </del>	<del> </del>	<del> </del>	
·	   <del></del>	<del></del>	·	#	<u> </u>	
<del>-</del>		!+ <del>-</del>	<u> </u>	#		<u> </u>
		<u></u>	<u> </u>	- <del>  </del>	<del> </del>	
	· —— -— ·— ·— ·—	<u>-</u>	<u>-</u>	#	-i	<del>                                     </del>
	- <del></del>		<u>'</u>	<del>     </del>	<del> </del>	<del> </del>
	·	! - <del></del>	<del>'</del>	<del>  </del>	<u> </u>	<del> </del> <del> </del>
			!	<del>                                     </del>		<del>   </del>
+	<del></del>	 	<del>                                     </del>	<del>                                     </del>	1	ļ
	<del></del>	├─-	<del> </del>			<del> </del>
	<del>-</del>	├ <del></del>	<del></del>	<del></del>		<del>!</del>
	<u></u>	·-	,	· <del> </del>		i

DAT	E	 	 

## TOWN OF LEXINGTON - BOARD OF PUBLIC WORKS

## WATER DIVISION

## Sketch of Service Here

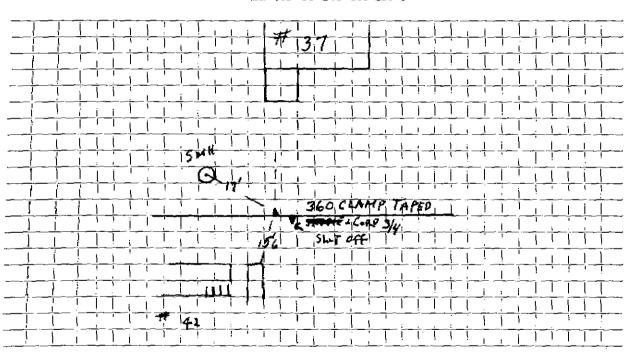

Connection made in	. Street.	Work completed
Remarks:		
***************************************		***************************************