

Name Louis Vanderwoude

Service No. ~~xx-54~~ 70

Address ~~42~~ Baker Ave.,

Location 39 Baker Ave.,

Kind of Pipe

Size

Size of Main

Repair—Renewal—New Service

Location

Date
1937

Material

Amount

Total

Date

Amount

7/21/37

2 hrs. @ 60¢ 1 20

1 20

32' 3/4" Copper Tubing @ 25¢

8 00

1 3/4" Stop & Waste

3 75

2 hrs. Trucking @ 75¢

1 50

\$14 45

Flat Rate:

32' @ 50¢

16 00

Trench Repairs

10 00

\$ 26 00

July 6, 1937 Deposited
Sept 1, 1937 Repaid

32 50

Labor

DATE July 15, 1937

TOWN OF LEXINGTON - BOARD OF PUBLIC WORKS

WATER DIVISION

The undersigned applies for a supply of water at No. 39, Baker Ave St. and hereby agrees to comply with the rules and regulations as now, or at any future time, established by the Board of Selectmen.

Am't. of Estimate \$ _____

Owner L. Van der Woude.


Am't. Paid \$ _____

Address 41 Baker Ave

Builder _____

Lexington,

Sketch of Service Here

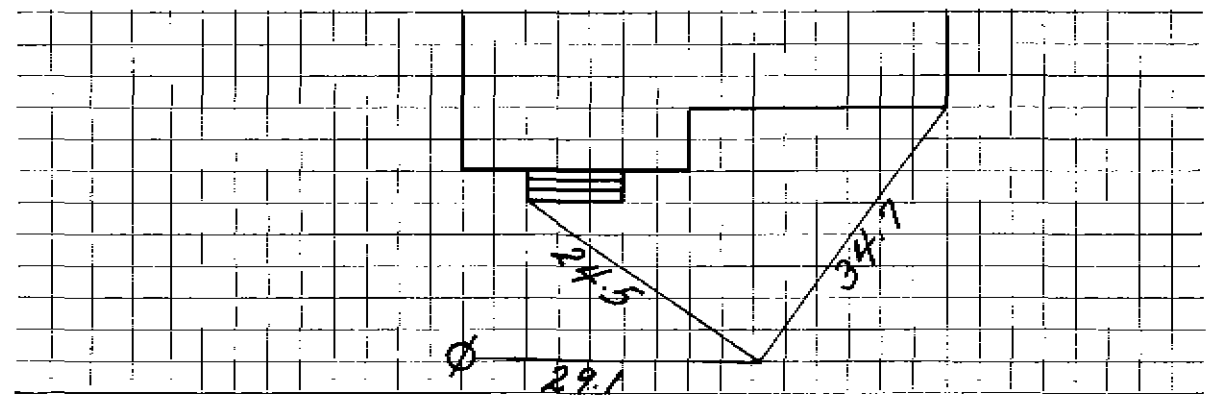

Connection made in _____ Street.

Work completed _____ 19

Remarks: