

Name Mrs. L. Vanderwoude
 Address 41 Baker Avenue

Service No. 14 71

Location Same
 Kind of Pipe Size Size of Main
~~Repair—Renewal—New Service~~ Location

Hadley Press, Inc., Lexington

Date	Material	Amount	Total	Date	Amount
1935 June 5	3 Hrs. Labor @ 60¢	1 80		<i>May 25 1935</i>	13 50
	10% Overhead	18	1 98		
	30' 1" C.I. Pipe @ 20¢	6 00			
	2 1" L.L. Coup. @ 25¢	50			
	1 1" 45° L.L.	77			
	1 1" L.L. Ell @ 30¢	30			
	1 1" Copper Nipple	20			
	1 S. & W.	2 75			
	Trucking	1 00	11 52		
			13 50		

*Copper on
 outside of
 Labor curb.*

DATE Feb - 20 - 1911

TOWN OF LEXINGTON - BOARD OF PUBLIC WORKS

WATER DIVISION

The undersigned applies for a supply of water at No. 41 Baker St. and hereby agrees to comply with the rules and regulations as now, or at any future time, established by the Board of Selectmen.

Am't. of Estimate \$ 13.50


Owner Mrs L van der Woude

Am't. Paid \$ 13.50

Address _____

Builder Reynold

Sketch of Service Here

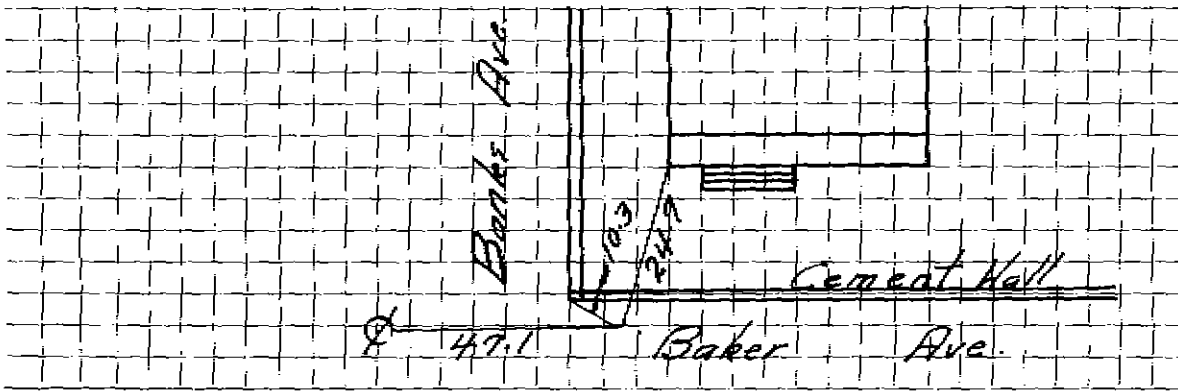

Connection made in _____ Street. Work completed _____ 19

Remarks: