

WATER SERVICE RECORD

Name

Service No.

Address 42 BAKER AVE

Location


Repair—Renewal—New Service

Date	Material	Amount	Total	Date	MELANDESON.	Amount
8-24-90	6" x 3/4" SERVICE SADDLE			8-24-90	INSIDE-LEAD OFF CURB	
	3/4" COPR					
	3/4" CURB COMP.			7-2-90	INSIDE RENEWED	
	8' - 3/4" COPPER					
	BOX + ROD				20' COPPER 3/4"	
	INSULATION MAIN TO CURB					

TOWN OF LEXINGTON — BOARD OF PUBLIC WORKS

WATER DIVISION

Sketch of Service Here

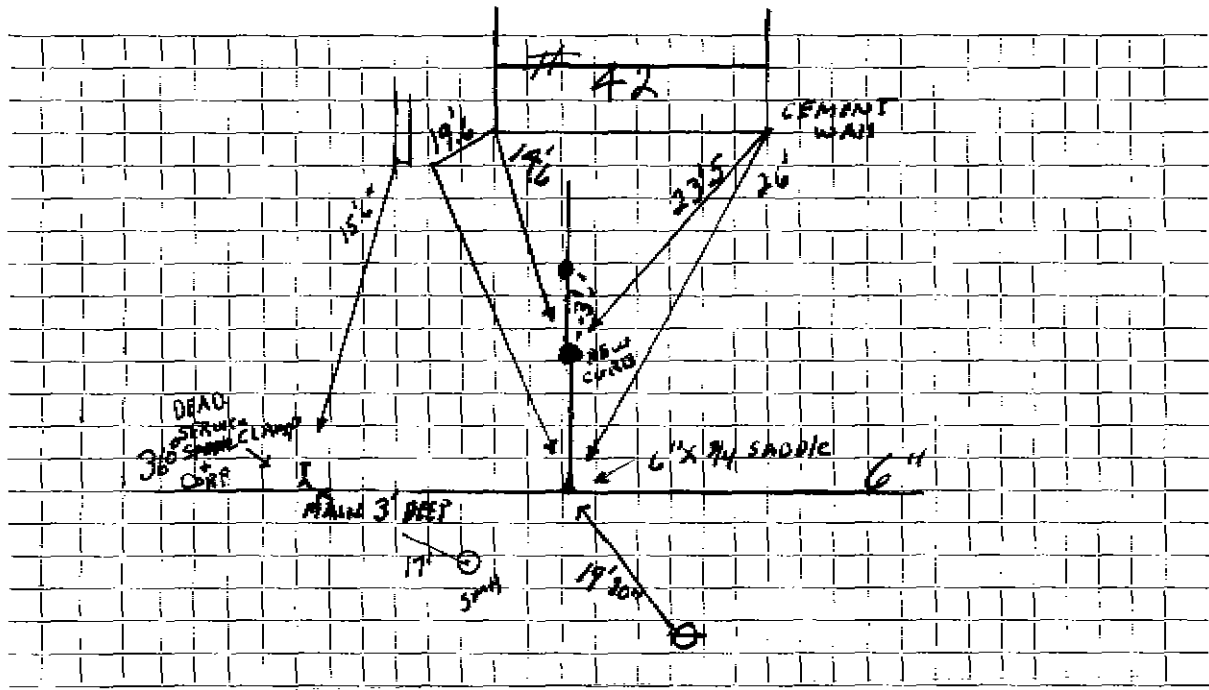

Connection made in BARRY ROSE GAS Co. Pulled Services Street. Work completed .....

Remarks: GOOSE NECK OFF CURB, 2' 2" Deep INSULATION MAIN TO CURB  
7.2.96 INSIDE RENEWED TO NEW CURB - tie the same