

WATER SERVICE RECORD

Name Elihu Schumann

Service No. 46

Address 51 Baker Avenue

Location Lexington, Mass.

~~Repair~~ - Renewal - ~~New Service~~


Com. 8-6-51

Date	Material	Amount	Total	Date	Amount
5/2/51	Labor	1 85	1 85	4-3-51	Deposited 20 00
	10% overhead		17		
	30' - 3/4" copper tubing @.326	9 78			No charge
	1 - 3/4" C x 1/2 I.W.F. stop&waste	4 00		5/2/51	Labor 1 65
	1 hr. trucking		75	18' - 3/4" copper tubing @.326	5 87
			16 35	1 - 3/4" C. corp-cock	4 33
				1 - 3/4" C x 3/4" Curb-cock	4 67
				1 - box and rod	4 68
				1 - 1/2 offset tail piece	50
				1 - 1/2 straight tail piece	50
				1 hr. trucking	75
					22 95

DATE \_\_\_\_\_

TOWN OF LEXINGTON — BOARD OF PUBLIC WORKS  
WATER DIVISION

Sketch of Service Here

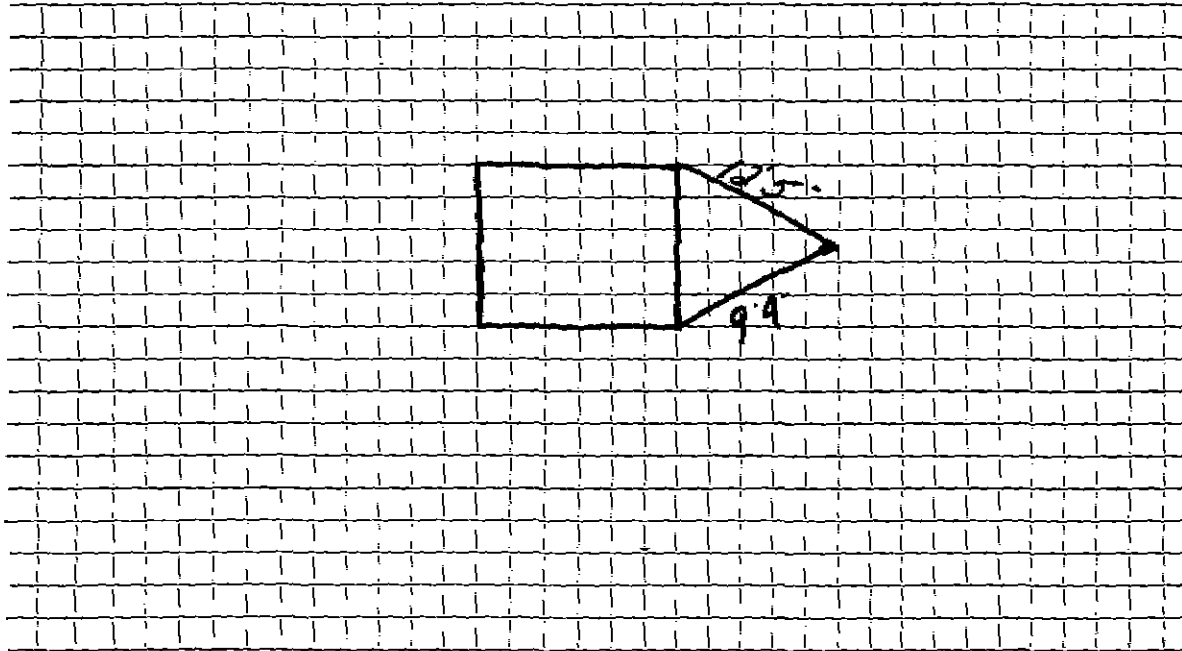

Connection made in ..... Street. Work completed .....

Remarks: .....

.....

.....