

Name Donald Irwin
 Address 57 Baker Avenue
 Lexington, Mass.

Service No. 39

511

Location 57 Baker Avenue

Kind of Pipe Size Size of Main

~~Repair~~ ~~Renewal~~ - New Service

Com. June 7, 1948

Location

Date	Material	Amount	Total	Date	Amount
Apr. 26, '48	Labor	4 85	4 85	April 24/48	5 00
	10% Overhead		49	June 10/48	9 09
	38' - 3/4" Copper Tubing @ .255	9 69	9 69		40 93
	1 - 3/4" C x 1/2" I.W.H. S & W	3 15	3 15	Apr. 26, '48	Labor
	Littlefield Shovel 1 hr. @ 7.00	7 00	7 00		5 80
	Trucking 1 hr. @ .75		75	21' - 3/4" Copper Tubing @ .255	5 36
	Patching 15 x 3		15 00	1 - 3/4" C Corp-cock	3 00
			40 93	1 - 3/4" C x 3/4" C Curb-cock	3 68
				1 - 3/4" C x 3/4" C Union (3pts)	1 32
				1 - Box & Rod	3 50
				Littlefield Shovel 1 hr. @ 7.00	7 00
				1 - 1/2" Offset Tail Piece	30
				1 - 1/2" Straight Tail Piece	30
				Trucking 1 hr. @ .75	75
					31 01

Hadley Press, Inc., Lexington

DATE _____

TOWN OF LEXINGTON—BOARD OF PUBLIC WORKS

WATER DIVISION

The undersigned applies for a supply of water at No. _____ St. and hereby agrees to comply with the rules and regulations as now, or at any future time, established by the Board of Selectmen.

Am't. of Estimate \$ _____


Owner _____

Am't. Paid \$ _____

Address 57 BAKER

Builder _____

Sketch of Service Here

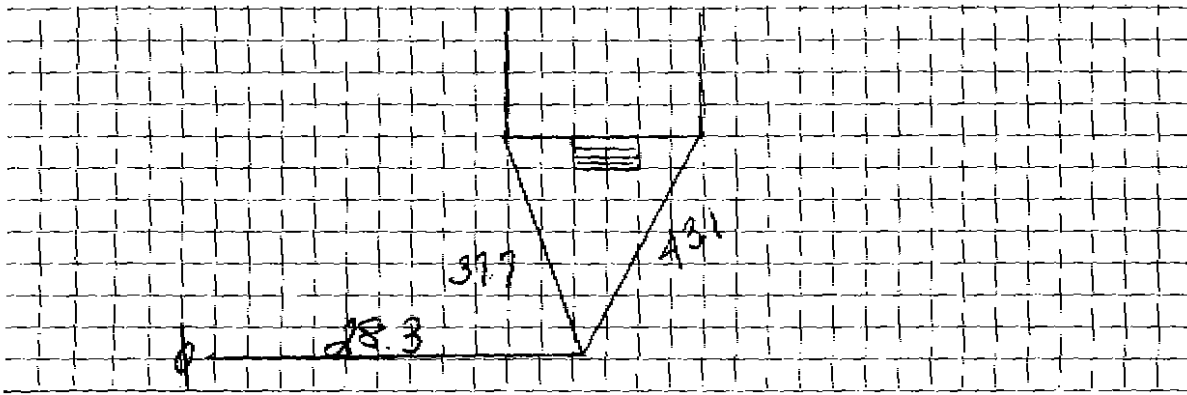

Connection made in _____ Street.

Work completed _____ 19

Remarks: