

Name Donald Irwin
 Address 60 Baker Avenue
 Lexington, Mass.

Service No.
 # 4586

Location 60 Baker Avenue

Kind of Pipe Size Size of Main

~~Repair—Renewal—New Service~~ Com. 8-23-48 Location

| Date | Material | Amount | Total | Date | Amount |
|-------------|-----------------------------------|--------|-------|--------------|--------------------------------|
| Jul. 8, '48 | Labor | 1 15 | 1 15 | July 7, '48 | 15 00 |
| | 10% Overhead | | 12 | July 20, '48 | 1 00 |
| | 30' - 3/4" Copper Tubing P.255 | 7 65 | 7 65 | | 14 00 |
| | 1 - 3/4" O x 1/2" I.D.R. S & W | 3 15 | | Jul. 8, '48 | Labor |
| | 1 - 3/4" O x 3/4" O Union (3-pts) | 1 32 | | | 1 15 |
| | Trucking 1 hr. 3.75 | 3 75 | 11 11 | | 10' - 3/4" Copper Tubing P.255 |
| | trench dug by owner. | | | | 3 57 |
| | Labor | | | | 1 - 3/4" O Comp-cock |
| | | | | | 3 00 |
| | | | | | 1 - 3/4" O x 3/4" O Gurb-cock |
| | | | | | 3 68 |
| | | | | | 1 - Box & Rod |
| | | | | | 3 55 |
| | | | | | 1 - 1/2" Straight Tail Piece |
| | | | | | 30 |
| | | | | | 1 - 3/8" Offset Tail Piece |
| | | | | | 30 |
| | | | | | Trucking 1 hr. 3.75 |
| | | | | | 75 |
| | | | | | 16 30 |

Deputed
Refunded
 Non-Charge

Hadley Press, Inc., Lexington

DATE _____

TOWN OF LEXINGTON—BOARD OF PUBLIC WORKS

WATER DIVISION

The undersigned applies for a supply of water at No. _____ St. and hereby agrees to comply with the rules and regulations as now, or at any future time, established by the Board of Selectmen.

Am't. of Estimate \$ _____


Owner _____

Am't. Paid \$ _____

Address _____

Builder _____

Sketch of Service Here

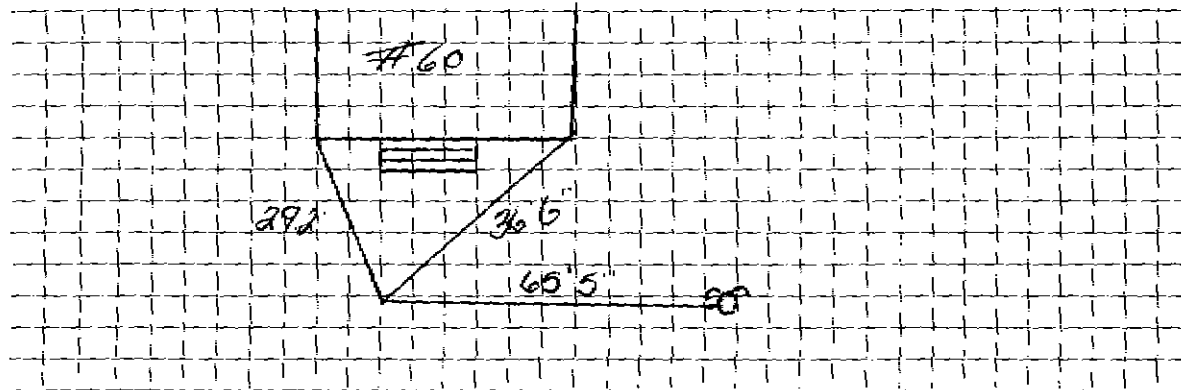

Connection made in _____ Street.

Work completed _____ 19

Remarks: