
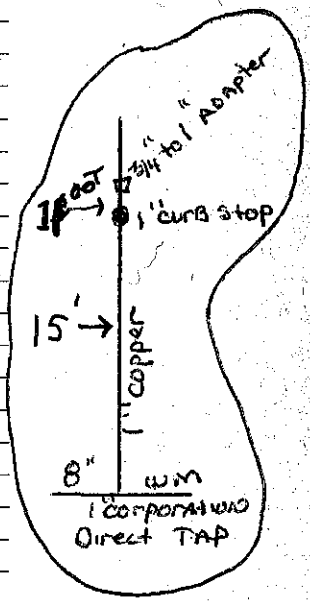


DATE 11-9-20

TOWN OF LEXINGTON — BOARD OF PUBLIC WORKS

WATER DIVISION

Sketch of Service Here

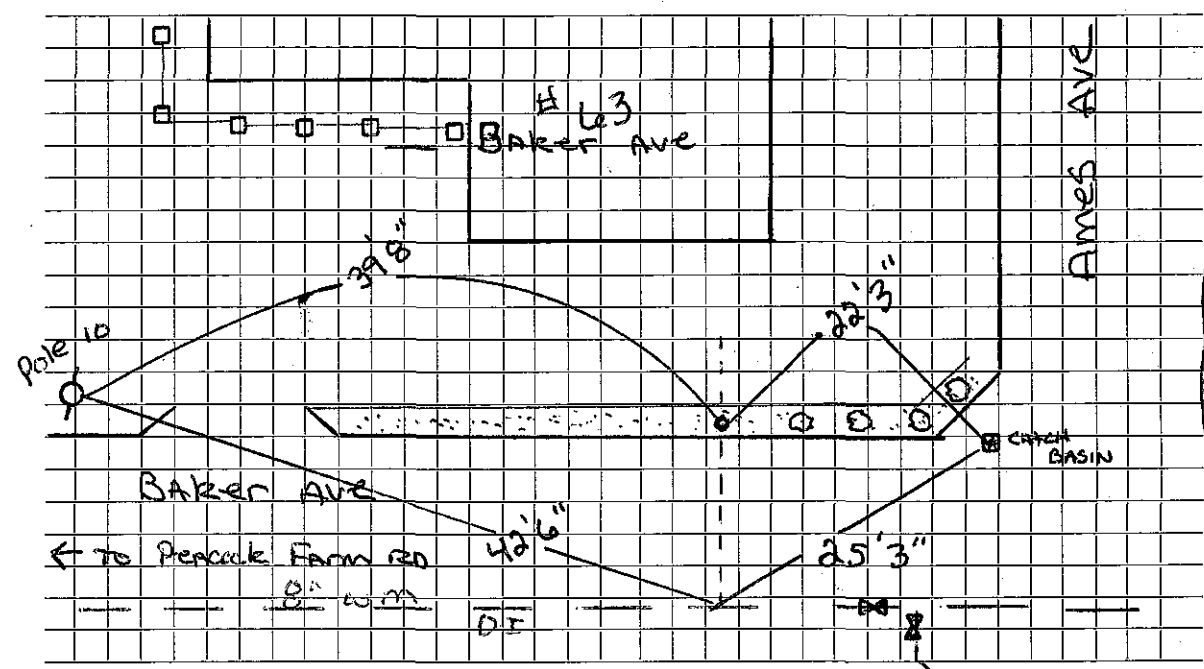

Connection made in Street. Work completed
440

Installed new main to Curb Stop

Remarks:
.....
.....