





DATE 11-9-20

TOWN OF LEXINGTON — BOARD OF PUBLIC WORKS

WATER DIVISION

Sketch of Service Here

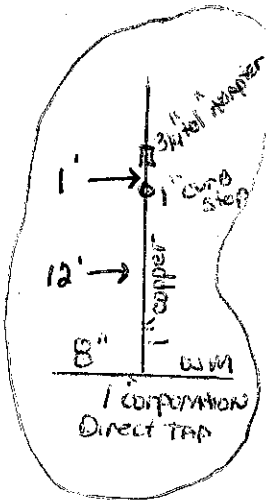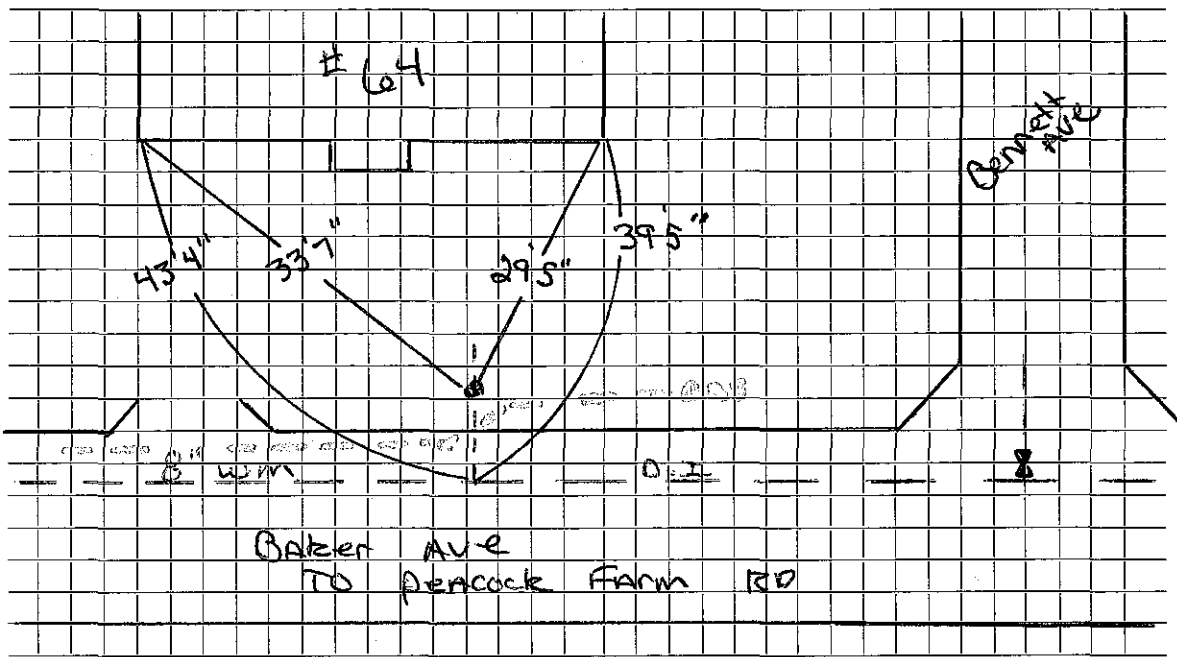

Connection made in..... Street. Work completed Installed new main to curb stop..

Remarks:.....  
.....  
.....