





DATE 10-27-20

TOWN OF LEXINGTON — BOARD OF PUBLIC WORKS

WATER DIVISION

Sketch of Service Here

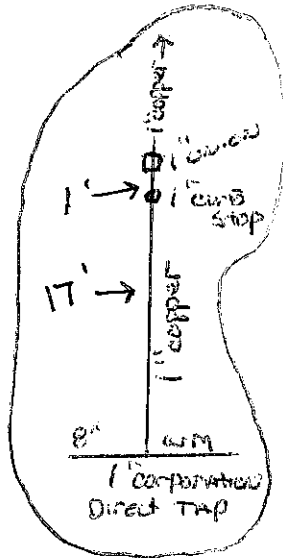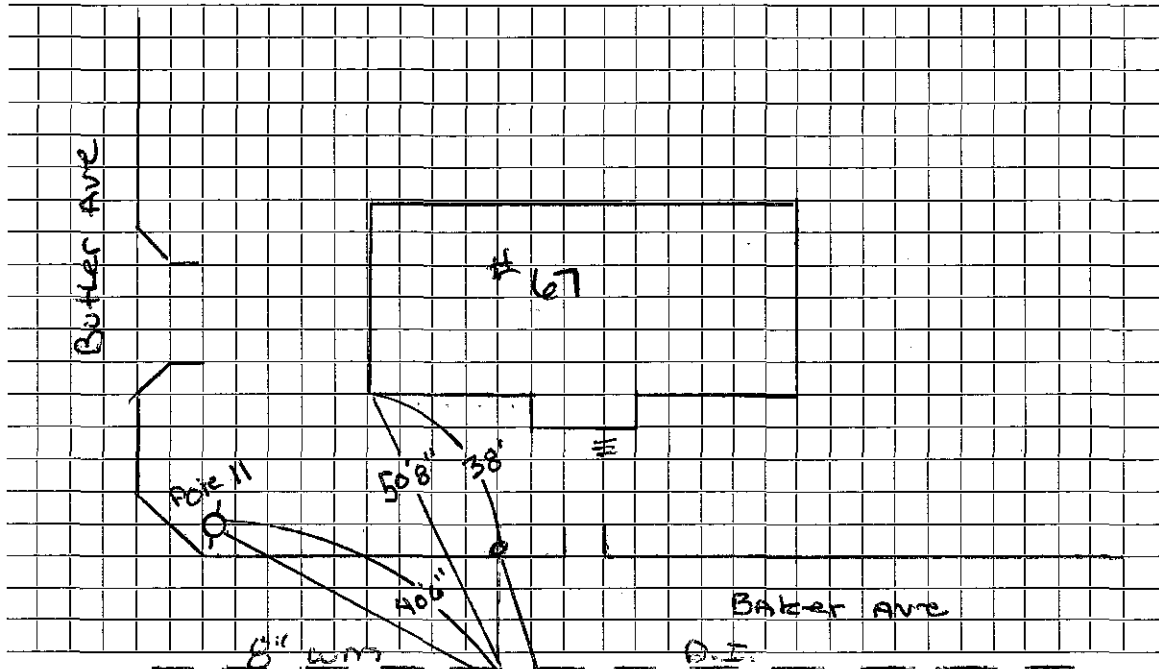

Connection made in ..... Street. 30'8" Work completed Installed new m.w.m. to curb stop..

Remarks: .....

.....

.....