

WATER SERVICE RECORD

Name _____ Service No. _____

Address 7 BAKER AVE RENEWED 9-2-92

Location _____

Repair—Renewal—New Service PERMIT NO. 0920 - BRUCE MCKEE

Date	Material	Amount	Total	Date	MCKEE	Amount
	1 1" iron to 3/4" copper adapter				RENEWAL	
	1 6" piece of 3/4" nipple			1/97		
	1 3/4" compression curb				28' 3/4 COPPER	
	18' 6" copper				VALUE	
	2 6" plastic to clay ferro					
	56" PVC 6"					
H. 14, 1997	WATER SERVICE RENEWED					


DATE 9-2-92

TOWN OF LEXINGTON — BOARD OF PUBLIC WORKS

WATER DIVISION

WATER SERVICE
RENEWED 1/14/97

8.2' Sketch of Service Here

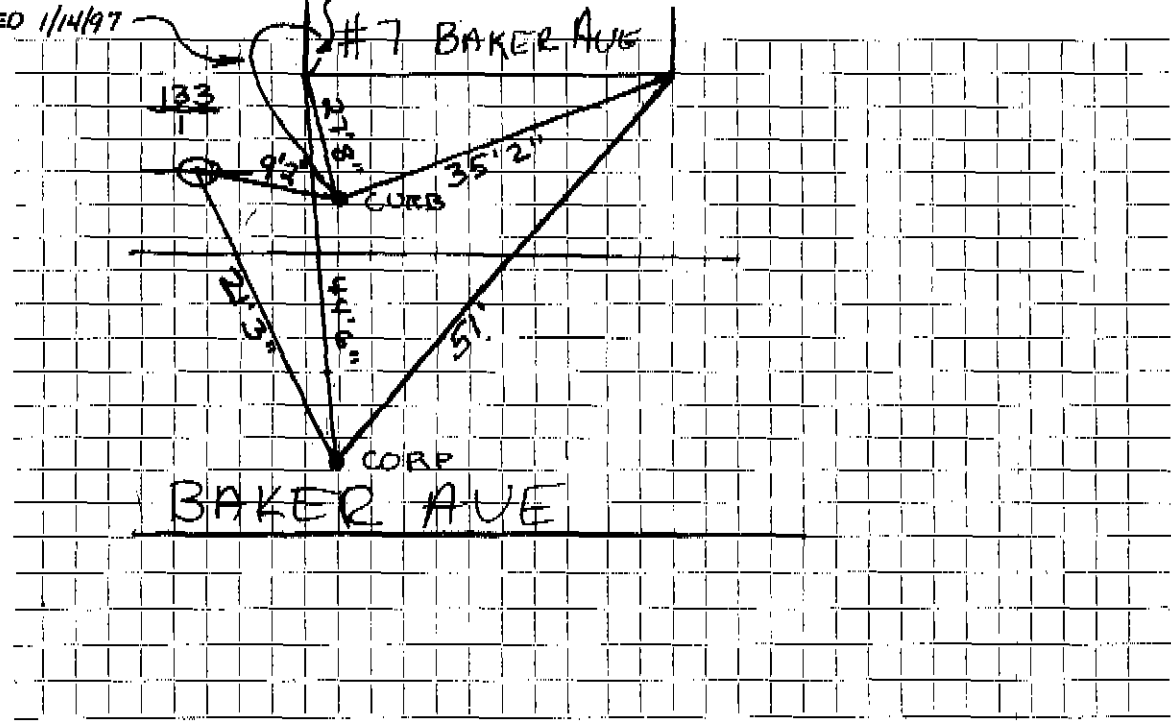

connection made in Street. Work completed

marks: