
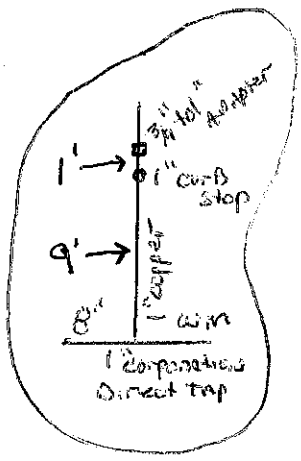


DATE 10-27-20

TOWN OF LEXINGTON — BOARD OF PUBLIC WORKS

WATER DIVISION

Sketch of Service Here

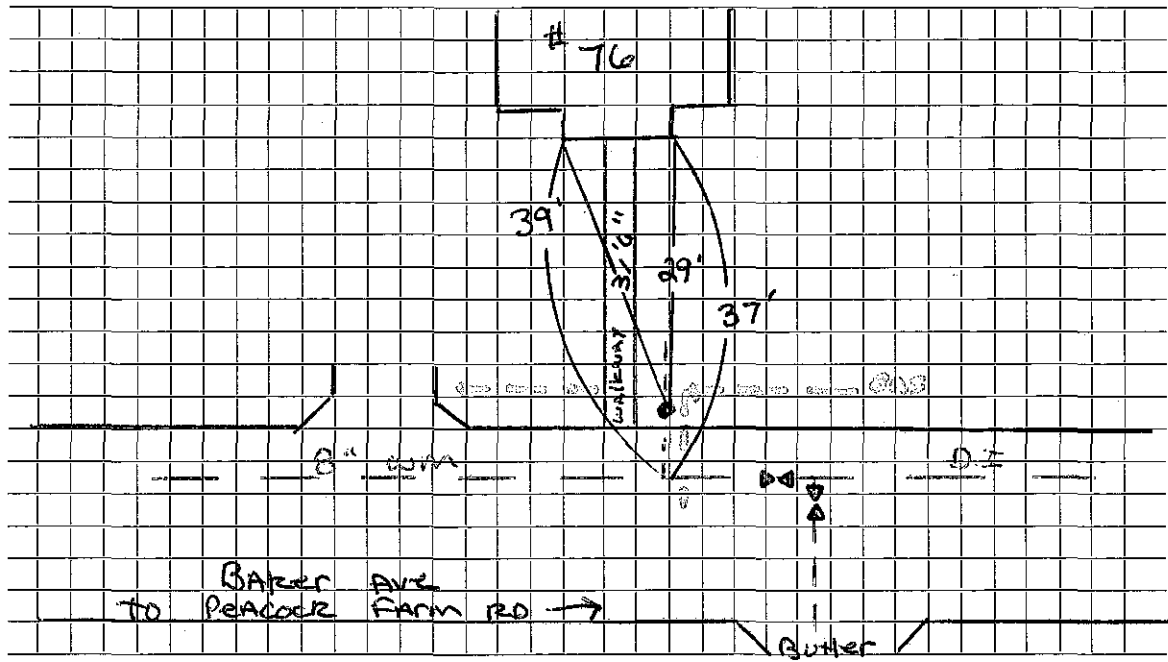

Connection made in Street. Work completed INSTALLED NEW MAIN TO CURB STOP

Remarks:

.....

.....