


TOWN OF LEXINGTON — BOARD OF PUBLIC WORKS

WATER DIVISION

Sketch of Service Here

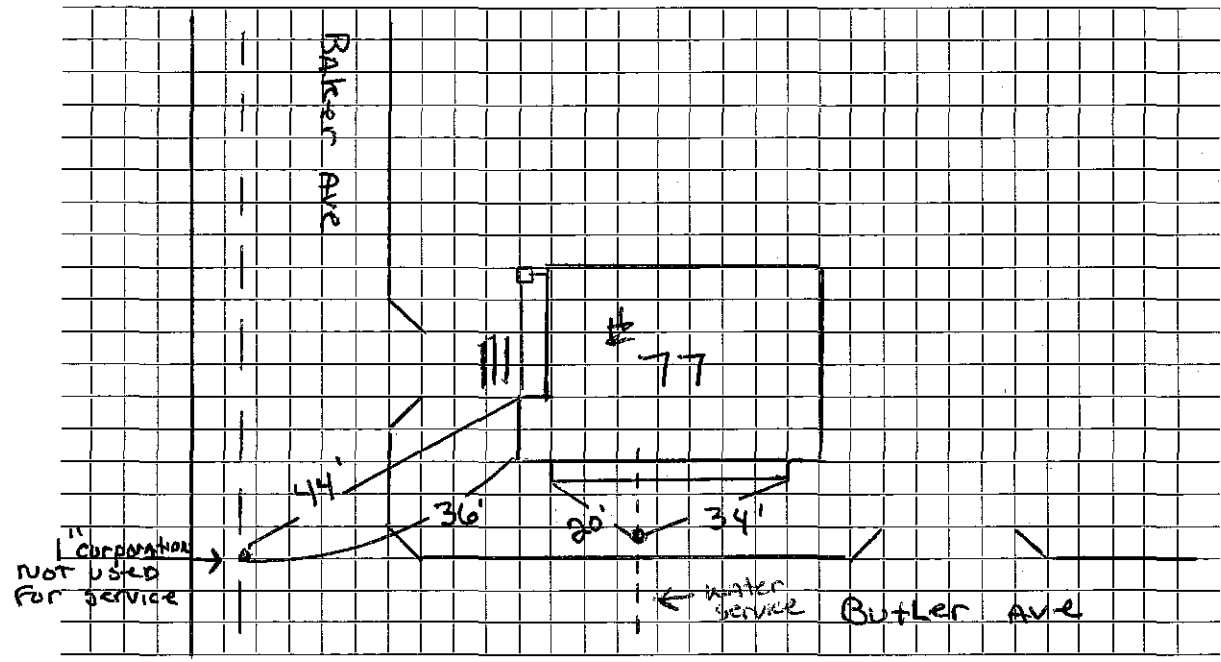

Connection made in Street.

Work completed New main to curb was installed...

Remarks:..... BUT FOUND OUT House is serviced from Butler Ave Corporation on Baker Ave WAS SHUT OFF AND pipe was removed.