

WATER SERVICE RECORD

Name HAMILTON COMPANYAddress #8 BAKER AVENUE

Service No.

Location

Repair--Renewal--New Service PERMIT NO. 0449 - MC LAUGHLIN


Date	Material	Amount	Total	Date	Amt
<u>3/31/95</u>	<u>1" # COPPER</u>				

DATE 31 MARCH 1995

TOWN OF LEXINGTON — BOARD OF PUBLIC WORKS

WATER DIVISION

Sketch of Service Here

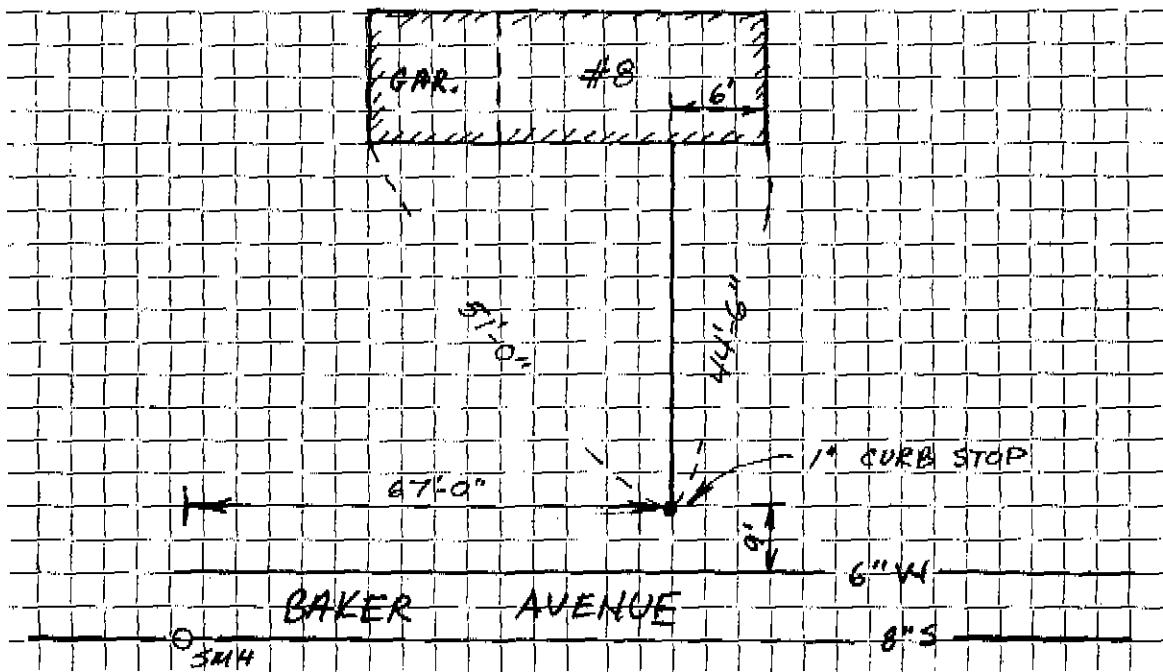

ion made in BAKER AVENUE Street. Work completed J.M. McLAUGHLIN.

s:

BOOK 96A

J.W.