
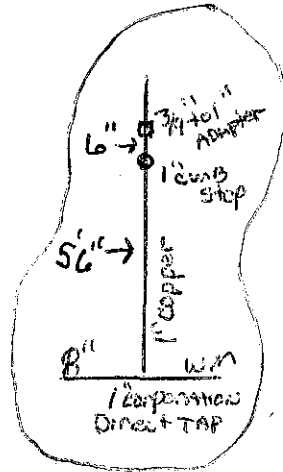


DATE 10-22-20

TOWN OF LEXINGTON — BOARD OF PUBLIC WORKS

WATER DIVISION

Sketch of Service Here

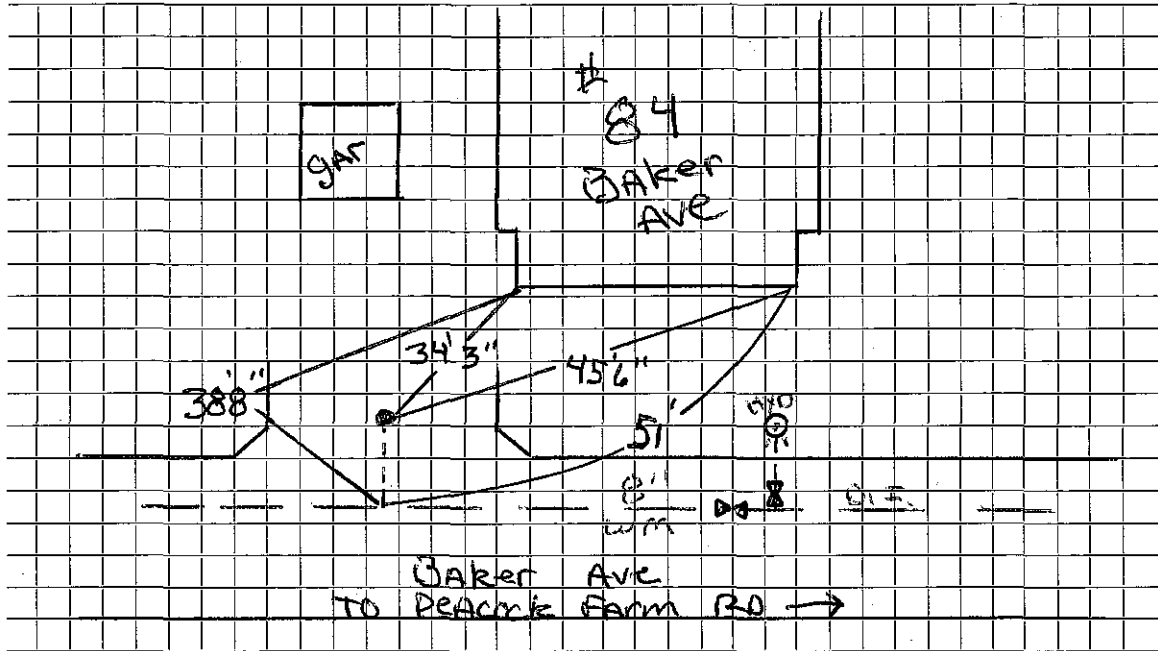

Connection made in Street.

Work completed INSTALLED new main to CONJ STOP.....

Remarks:
.....
.....