

WATER SERVICE RECORD

4884

Name Herbert G. McConchie

Service No. 58

Address # 12 BALFOUR ST LOT 9

Location

New Service WO #7242

Conn. 7-16-62


Date	Material	Amount	Total	Date	Amount	
5/22/62	Labor	3 86		5-16-62	Deposit	50 00
	10% O.H.	39	4 25	7-16-62	Refund	14 38
	60' 3/4" Copper Tubing @ .42		25 20			35 62
	1 3/4" Cx 1/2 I.W.H. Stop & Waste		6 17			
			35 62		NON CHARGE	
				8-2-62	Labor	3.92
					30' 3/4" Copper Tubing @.42	12.60
					1 3/4" C Corp Cock	4.91
					1 3/4" C Curb Cock	6.28
					1 Box & Rod	4.90
						32.61
					1 1/2 Straight Tailpiece	50
					1 1/2 Offset Tailpiece	50
						33 61

DATE _____

TOWN OF LEXINGTON — BOARD OF PUBLIC WORKS

WATER DIVISION

Sketch of Service Here

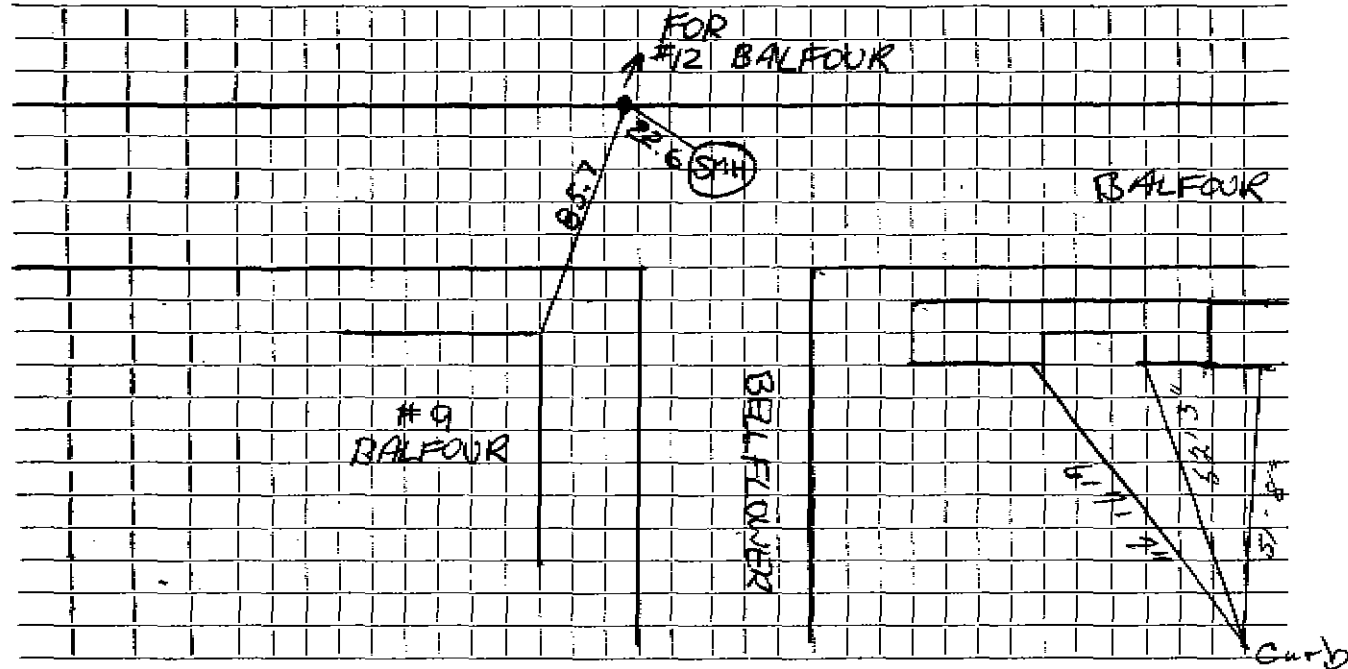

Connection made in _____ Street. Work completed

Remarks:
.....
.....