

WATER SERVICE RECORD

Name Lealand Construction

Service No. 5

Address 15 Pallour Street

1902

Location Lexington

Repair ~~Renewal~~ — New Service

DOM. 2-4-52


| Date | Material | Amount | Total | Date | Amount |
|---------|------------------------------------|--------|-------|----------------------------------|------------|
| 1/28/52 | Labor | 5 52 | 5 52 | 1-23-52 Deposited | 50 00 |
| | 10% overhead | | 55 | 2-4-52 Refunded | (9 71) |
| | 45' - 3/4" copper tubing @ .3439 | | 15 47 | | NON CHARGE |
| | 1 - 3/4" C x 3/4" I.D.F. stopwaste | | 4 00 | 1/28/52 Labor | 5 95 |
| | 2 hrs. Littlefield shovel | | 14 00 | 10' - 3/4" Copper tubing @ .3439 | 3 44 |
| | 1 hr. trucking | | 75 | 1 - 3/4" C. comp-cock | 4 52 |
| | | | 40 29 | 1 - 3/4" C x 3/4" C. curb-cock | 4 87 |
| | | | | 1 box rod | 4 52 |
| | | | | 1 - 3/4" straight tail piece | 50 |
| | | | | 1 - 3/4" offset tail piece | 50 |
| | | | | 1 hr. Littlefield shovel | 7 00 |
| | | | | 1 hr. trucking | 75 |
| | | | | | 31 86 |

DATE _____

TOWN OF LEXINGTON — BOARD OF PUBLIC WORKS

WATER DIVISION

Sketch of Service Here

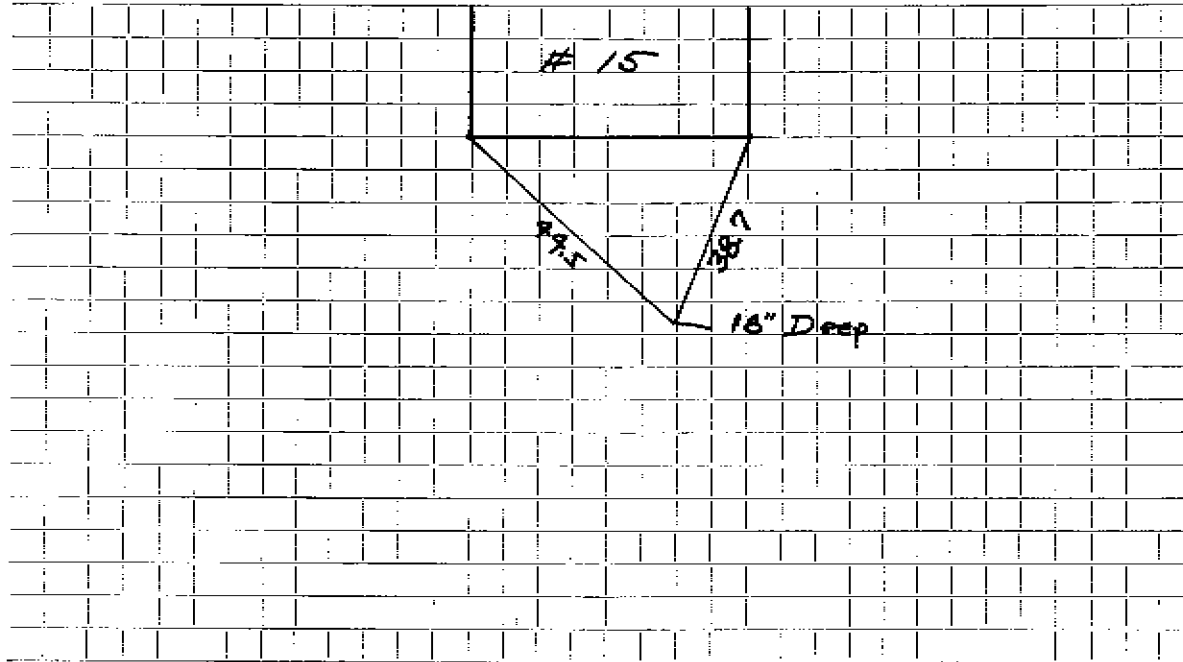

Connection made in Street. Work completed

Remarks:
.....
.....